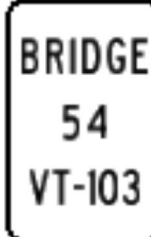
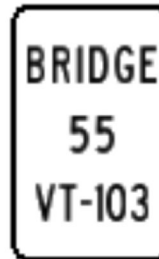
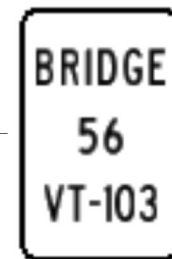


DIRECTION	MILEPOINT	LOCATION CODE (SHEET 4)	SIGN CODE	WIDTH (IN)	HEIGHT (IN)	SHEETING REMARKS	SIGN LEGEND	NEW SIGNS		EXISTING SIGNS				EXIST POST		NUMBER OF NEW POSTS	SQUARE STEEL (IN)			TUBULAR STEEL Ø (IN)				SIGN FRAME REQUIRED	REMARKS	SIGN DETAIL LOCATION					
								"A"	"B"	RETAIN	SALVAGE FROM	SALVAGE TO	REMOVE	RETAIN	REMOVE		1.75	2.00	2.50	FOUNDATION	3.00	3.50	4.00			5.00	SHSM	SIGN DETAILS SHEET #	STANDARD SHEET #		
																	(LB / FT)				(LB / FT)										
																	1.88	2.42	3.35		7.60	9.00	10.80			14.60					
NB CLARENDON VT ROUTE 103							FY-FLUORESCENT YELLOW FYG-FLUORESCENT YELLOW GREEN															"SHSM"-STANDARD HIGHWAY SIGNS AND MARKINGS BOOK									
NB	1.123	A	VD-701	6	10		 11/28/17	0.42								1	8'-6" X							INSTALL 10' SOUTH OF EXISTING SB BRIDGE PLAQUE AT MP 1.138 SB			T-42				
NB	1.158	C	VR-023b				 10/16/17						1	X																	
		C	VR-023b	24	30			5.00																INSTALL ON RETAINED POST			T-70				
NB	1.238	A	VD-701				 10/16/17						1	X																	
		A	VD-701	6	10			0.42																INSTALL ON RETAINED POST			T-42				
NB	1.386	A	VD-062B				OFFICIAL BUSINESS DIRECTIONAL SIGN			1				X										Airport Industrial Park, Left on 7B							
		A	VD-062B				OFFICIAL BUSINESS DIRECTIONAL SIGN			1														Cape Air Jet Blue Airways							
NB	1.406	A	VD-701				 10/17/17						1		X																
		A	VD-701	6	10			0.42								1	7'-9" X										T-42				
NB	1.434	A					RUTLAND SOUTHERN VERMONT REGIONAL AIRPORT ←---			1				X																	
NB	1.439	C	W14-2				NO OUTLET			1				X																	
		C					SERVICE ROAD			1																					
NB	1.629	A	W2-1				 10/16/17							1	X																
		A	W13-1P				40 M.P.H.																								
		A	W2-1	30	30			6.25																THINNING AND TRIMMING							
																								INSTALL ON RETAINED POST	X						
SIGN SUMMARY SHEET							SHEET TOTALS	12.50	0.00	5	0	0	5	0	0	2		20.0		0	0.0	0.0	0.0	0.0	PROJECT NAME: STATEWIDE-SOUTH REGION	PROJECT NUMBER: STPG SIGN(57)					
								SF	SF	EA	EA	EA	EA	EA	EA	EA		FT		EA	LB	LB	LB	LB							
							VERMONT AGENCY OF TRANSPORTATION																					FILE NAME: z16t041Clarendon103 NB.xls	PLOT DATE: 2/27/2017		
														TOWN DIRECTIONAL TOTALS	182.0	0.0	16	2	2	53	0	0	14		200.0		0		0.0		DESIGNED BY: P. MCKECHNIE
																								CHECKED BRZEZOWSKI	SHEET 136 OF 264						