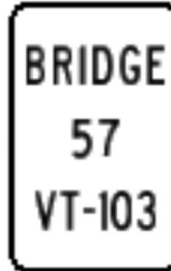


DIRECTION	MILEPOINT	LOCATION CODE (SHEET 4)	SIGN CODE	WIDTH (IN)	HEIGHT (IN)	SHEETING REMARKS	SIGN LEGEND	NEW SIGNS		EXISTING SIGNS				EXIST POST		NUMBER OF NEW POSTS	SQUARE STEEL (IN)			TUBULAR STEEL Ø (IN)				SIGN FRAME REQUIRED	REMARKS	SIGN DETAIL LOCATION			
								"A"	"B"	RETAIN	SALVAGE FROM	SALVAGE TO	REMOVE	RETAIN	REMOVE		1.75	2.00	2.50	FOUNDATION	3.00	3.50	4.00			5.00	SHSM	SIGN DETAILS SHEET #	STANDARD SHEET #
																	(LB / FT)				(LB / FT)								
																	1.88	2.42	3.35		7.60	9.00	10.80			14.60			
NB CLARENDON VT ROUTE 103							FY-FLUORESCENT YELLOW FYG-FLUORESCENT YELLOW GREEN															"SHSM"-STANDARD HIGHWAY SIGNS AND MARKINGS BOOK							
		A	W13-1P	18	18			2.25																X					
NB	1.655	A	VD-701				 10/16/17						1	X															
		A	VD-701	6	10			0.42																		T-42			
NB	1.670	A	M2-1										1	X															
		A	VM1-5										1																
		A	M2-1	21	15		 10/17/17	2.19																X					
		A	VM1-5	24	24			4.00																		E-136			
NB	1.758	A	M3-3										1		X														
		A	VM1-5										1																
		A	M6-1										1																
		A	M3-1										1																
		A	VM1-5										1																
		A	M6-3										1																
		A	M3-1										1																
		A	VM1-5										1																
SIGN SUMMARY SHEET							SHEET TOTALS	8.85	0.00	0	0	0	11	0	0	0	0.0			0	0.0	0.0	0.0	0.0	PROJECT NAME: STATEWIDE-SOUTH REGION				
								SF	SF	EA	EA	EA	EA	EA	EA	EA	FT			EA	LB	LB	LB	LB	PROJECT NUMBER: STPG SIGN(57)				
																				EA	LB		LB			FILE NAME: z16t041Clarendon103 NB.xls			
VERMONT AGENCY OF TRANSPORTATION							TOWN DIRECTIONAL TOTALS	182.0	0.0	16	2	2	53	0	0	14	200.0			0	0.0			PLOT DATE: 2/27/2017					
																										DRAWN BY: W. GORDON			
																										CHECKED: BRZEZOWSKI			
																										SHEET 137 OF 264			