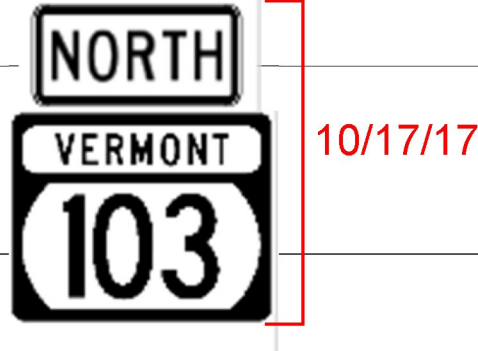
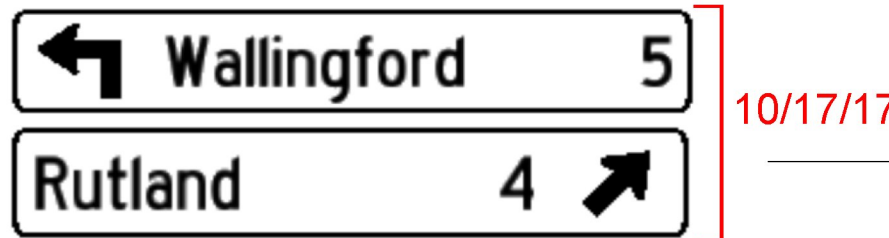
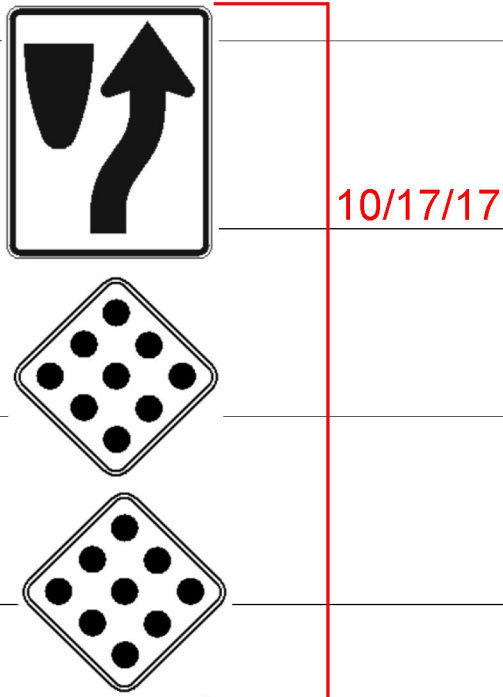


DIRECTION	MILEPOINT	LOCATION CODE (SHEET 4)	SIGN CODE	WIDTH (IN)	HEIGHT (IN)	SHEETING REMARKS	SIGN LEGEND	NEW SIGNS		EXISTING SIGNS				EXIST POST		NUMBER OF NEW POSTS	SQUARE STEEL (IN)			TUBULAR STEEL Ø (IN)				SIGN FRAME REQUIRED	REMARKS	SIGN DETAIL LOCATION			
								"A"	"B"	RETAIN	SALVAGE FROM	SALVAGE TO	REMOVE	RETAIN	REMOVE		1.75	2.00	2.50	FOUNDATION	3.00	3.50	4.00			5.00	SHSM	SIGN DETAILS SHEET #	STANDARD SHEET #
																	(LB / FT)				(LB / FT)								
																	1.88	2.42	3.35		7.60	9.00	10.80			14.60			
NB CLARENDON VT ROUTE 103							FY-FLUORESCENT YELLOW FYG-FLUORESCENT YELLOW GREEN															"SHSM"-STANDARD HIGHWAY SIGNS AND MARKINGS BOOK							
NB	1.812	A	M3-1									1	X																
		A	VM1-5										1																
		A	M3-1	24	12			2.00																INSTALL ON RETAINED POST NORTH, GREEN ON WHITE	X				
		A	VM1-5	30	24			5.00																		E-136			
NB	1.850	A	VD1-1A				(UP AND LEFT HOOK ARROW) WALLINGFORD 5					1	X																
		A	VD1-1A				RUTLAND 4 (UP AND RIGHT DIAGONAL)					1																	
		A	VD1-1A	72	12			6.00																INSTALL ON RETAINED POSTS			T-93		
		A	VD1-1A	72	12			6.00																		T-93			
NB	1.878	J	R4-7									1	X																
		J	OM1-1										1																
		K	OM1-1										1																
		J	R4-7	24	30			5.00																INSTALL ON RETAINED POST	X				
		J	OM1-1	18	18			2.25																					
		K	OM1-1	18	18			2.25																INSTALL BACK TO BACK ON SIGN POST	X				
SIGN SUMMARY SHEET							SHEET TOTALS	28.50	0.00	0	0	0	7	0	0	0	0.0			0	0.0	0.0	0.0	0.0	PROJECT NAME: STATEWIDE-SOUTH REGION				
								SF	SF	EA	EA	EA	EA	EA	EA	EA		FT		EA	LB	LB	LB	LB	PROJECT NUMBER: STPG SIGN(57)				
																										FILE NAME: z16t041Clarendon103 NB.xls	PLOT DATE: 2/27/2017		
							VERMONT AGENCY OF TRANSPORTATION							TOWN DIRECTIONAL TOTALS	182.0	0.0	16	2	2	53	0	0	14	200.0			0	0.0	
																							DESIGNED BY: P. MCKECHNIE		CHECKED: BRZEZOWSKI				
																							CLARENDON VT-103 NB 6		SHEET 139 OF 264				