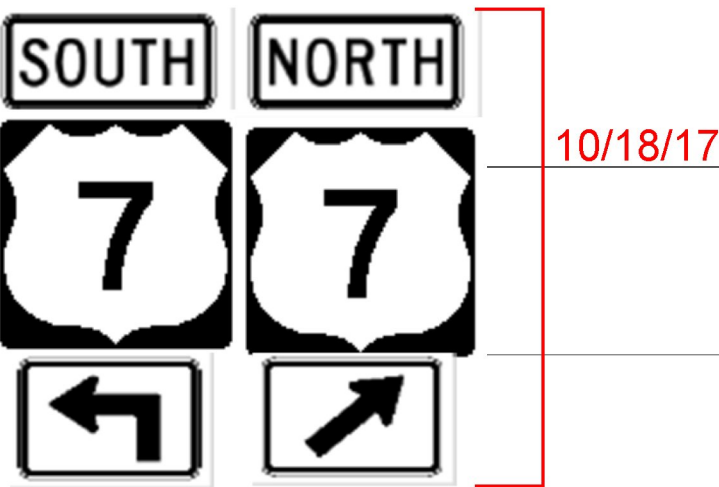


DIRECTION	MILEPOINT	LOCATION CODE (SHEET 4)	SIGN CODE	WIDTH (IN)	HEIGHT (IN)	SHEETING REMARKS	SIGN LEGEND	NEW SIGNS		EXISTING SIGNS				EXIST POST		NUMBER OF NEW POSTS	SQUARE STEEL (IN)			TUBULAR STEEL Ø (IN)				SIGN FRAME REQUIRED	REMARKS	SIGN DETAIL LOCATION									
								"A"	"B"	RETAIN	SALVAGE FROM	SALVAGE TO	REMOVE	RETAIN	REMOVE		1.75	2.00	2.50	FOUNDATION	3.00	3.50	4.00			5.00	SHSM	SIGN DETAILS SHEET #	STANDARD SHEET #						
																	(LB / FT)				(LB / FT)														
<b>NB CLARENDON VT ROUTE 103</b>							FY-FLUORESCENT YELLOW FYG-FLUORESCENT YELLOW GREEN																"SHSM"-STANDARD HIGHWAY SIGNS AND MARKINGS BOOK												
NB	1.891	A	M3-3				SOUTH					1	X																						
		A	M1-4				US ROUTE 7					1																							
		A	M5-1L				LEFT HOOK ARROW					1																							
		A	M3-1				NORTH					1																							
		A	M1-4				US ROUTE 7					1																							
		A	M6-2R				DIAGONAL UP RIGHT					1																							
		A	M3-3	24	12			2.00																											
		A	M1-4	24	24			4.00																											
		A	M5-1L	21	15			2.19																											
		A	M3-1	24	12			2.00																											
		A	M1-4	24	24			4.00																											
		A	M6-2R	21	15			2.19																											
																																			
NB	1.929	A	M3-3				SOUTH					1	X																						
		A	M1-4				US ROUTE 7					1																							
		A	M6-1				LEFT ARROW					1																							
<b>SIGN SUMMARY SHEET</b>							<b>SHEET TOTALS</b>	16.38	0.00	0	0	0	9	0	0	0	0.0	0	0.0	0.0	0.0	0.0	0.0	0.0	0.0	0.0	0.0	PROJECT NAME: STATEWIDE-SOUTH REGION PROJECT NUMBER: STPG SIGN(57)							
VERMONT AGENCY OF TRANSPORTATION							<b>TOWN DIRECTIONAL TOTALS</b>	182.0	0.0	16	2	2	53	0	0	14	200.0	0		0.0								FILE NAME: z16t041Clarendon103 NB.xls PROJECT MANAGER: D. MUNRO DESIGNED BY: P. MCKECHNIE CLARENDON VT-103 NB 7	PLOT DATE: 2/27/2017 DRAWN BY: W. GORDON CHECKED: BRZEZOWSKA SHEET 140 OF 264						