
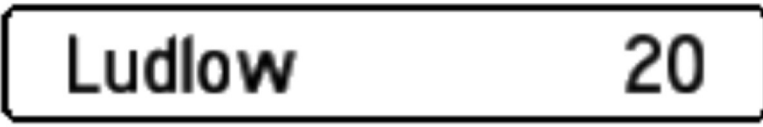





DIRECTION	MILEPOINT	LOCATION CODE (SHEET 4)	SIGN CODE	WIDTH (IN)	HEIGHT (IN)	SHEETING REMARKS	SIGN LEGEND	NEW SIGNS		EXISTING SIGNS				EXIST POST		NUMBER OF NEW POSTS	SQUARE STEEL (IN)			TUBULAR STEEL Ø (IN)				SIGN FRAME REQUIRED	REMARKS	SIGN DETAIL LOCATION			
								"A"	"B"	RETAIN	SALVAGE FROM	SALVAGE TO	REMOVE	RETAIN	REMOVE		1.75	2.00	2.50	FOUNDATION	3.00	3.50	4.00			5.00	SHSM	SIGN DETAILS SHEET #	STANDARD SHEET #
																	(LB / FT)				(LB / FT)								
<b>SB CLARENDON VT ROUTE 103</b>							FY-FLUORESCENT YELLOW FYG-FLUORESCENT YELLOW GREEN															"SHSM"-STANDARD HIGHWAY SIGNS AND MARKINGS BOOK							
SB	1.960	F	R1-2				 11/28/17																						
		F	R1-2	36	36																								
SB	1.930	F	VD1-1A																										
		F	VD2-1	72	12		 10/16/17																						
SB	1.906	F	W2-1				 10/16/17																						
		F	W13-1P																										
		F	W2-1	30	30		 10/17/17																						
		F	W13-1P	18	18																								
SB	1.886	F	M2-1																										
		F	VM1-5																										
		F	M2-1	21	15		 10/16/17																						
		F	VM1-5	24	24																								
SB	1.856	F	VD-062B				OFFICIAL BUSINESS DIRECTIONAL SIGN																						
		F	VD-062B				OFFICIAL BUSINESS DIRECTIONAL SIGN																						
SB	1.798	F	M3-1				NORTH																						
<b>SIGN SUMMARY SHEET</b>							<b>SHEET TOTALS</b>	24.59	0.00	2	0	0	7	0	0	1	15.0	0	0.0	0.0	0.0	0.0	PROJECT NAME: STATEWIDE-SOUTH REGION						
							SF	SF	EA	EA	EA	EA	EA	EA	EA	EA	FT	EA	LB	LB	LB	LB	PROJECT NUMBER: STPG SIGN(57)						
VERMONT AGENCY OF TRANSPORTATION							<b>TOWN DIRECTIONAL TOTALS</b>	142.7	0.0	4	1	1	34	0	0	13	185.0	0		0.0			FILE NAME: z16t041Clarendon103 SB.xls	PLOT DATE: 2/27/2017					
																						PROJECT MANAGER: D. MUNRO	DRAWN BY: W. GORDON						
																						DESIGNED BY: P. MCKECHNIE	CHECKED: BRZEZOWSK						
																						CLARENDON VT-103 SB 1	SHEET 143 OF 264						