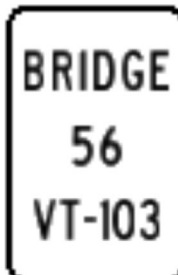
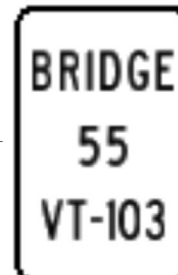
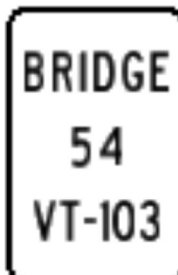


DIRECTION	MILEPOINT	LOCATION CODE (SHEET 4)	SIGN CODE	WIDTH (IN)	HEIGHT (IN)	SHEETING REMARKS	SIGN LEGEND	NEW SIGNS		EXISTING SIGNS				EXIST POST		NUMBER OF NEW POSTS	SQUARE STEEL (IN)			TUBULAR STEEL Ø (IN)				SIGN FRAME REQUIRED	REMARKS	SIGN DETAIL LOCATION																	
								"A"	"B"	RETAIN	SALVAGE FROM	SALVAGE TO	REMOVE	RETAIN	REMOVE		1.75	2.00	2.50	FOUNDATION	3.00	3.50	4.00			5.00	SHSM	SIGN DETAILS SHEET #	STANDARD SHEET #														
																	(LB / FT)				(LB / FT)																						
																	1.88	2.42	3.35		7.60	9.00	10.80			14.60																	
SB CLARENDON VT ROUTE 103							FY-FLUORESCENT YELLOW FYG-FLUORESCENT YELLOW GREEN															"SHSM"-STANDARD HIGHWAY SIGNS AND MARKINGS BOOK																					
SB	1.555	F	VR-921R	30	30		 10/17/17	6.25								1	13'-6" X						INSTALL SIGN 175' UPSTATION FROM EXISTING SIGN AT MP 1.522 SB AT BEGINNING OF SOLID WHITE LINE			E-145																	
SB	1.522	F					 RUTLAND SOUTHERN VERMONT REGIONAL AIRPORT ->			1				X																													
		F	D4-2R				 PARK & RIDE ->			1																																	
SB	1.483	G	VR-079	24	30		 10/16/17	5.00								1	12'-9" X						AIRPORT RD (TH-7) INSTALL ON LEGAL LOAD SIDE OF INTERSECTION			T-71																	
SB	1.472	H	R1-1				 10/16/17						1		X																												
		F	D3-1	42	12		 10/16/17	3.50								1	12'-9" x						INSTALL ON TOP OF STOP SIGN		8																		
		H	R1-1	30	30			6.25														X																					
SB	1.415	F	VD-701				 10/16/17						1		X																												
		F	VD-701	6	10			0.42								1	7'-9" X								T-42																		
SB	1.262	F	VW-202				 10/16/17						1	X																													
		F	VW-202	30	30			6.25															INSTALL ON RETAINED POST			T-81																	
SB	1.253	F	VD-701				 10/16/17						1	X																													
		F	VD-701	6	10			0.42															INSTALL ON RETAINED POST			T-42																	
SB	1.138	F	VD-701				 10/16/17						1	X																													
		F	VD-701	6	10			0.42															INSTALL ON RETAINED POST			T-42																	
SIGN SUMMARY SHEET							SHEET TOTALS											28.50	0.00	2	0	0	5	0	0	4	55.0			0	0.0	0.0	0.0	PROJECT NAME: STATEWIDE-SOUTH REGION PROJECT NUMBER: STPG SIGN(57)									
							SF	SF	EA	EA	EA	EA	EA	EA	EA	EA	FT	EA	LB	LB	LB	LB																					
							TOWN DIRECTIONAL TOTALS											142.7	0.0	4	1	1	34	0	0	13	185.0			0	0.0												
							VERMONT AGENCY OF TRANSPORTATION																						FILE NAME: z16t041Clarendon103 SB.xls PROJECT MANAGER: D. MUNRO DESIGNED BY: P. MCKECHNIE CLARENDON VT-103 SB 4											PLOT DATE: 2/27/2017 DRAWN BY: W. GORDON CHECKED: BRZEZOWSKI SHEET 146 OF 264			