



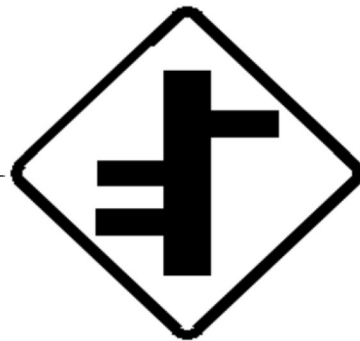



DIRECTION	MILEPOINT	LOCATION CODE (SHEET 4)	SIGN CODE	WIDTH (IN)	HEIGHT (IN)	SHEETING REMARKS	SIGN LEGEND	NEW SIGNS		EXISTING SIGNS			EXIST POST		NUMBER OF NEW POSTS	SQUARE STEEL (IN)			TUBULAR STEEL Ø (IN)				SIGN FRAME REQUIRED	REMARKS	SIGN DETAIL LOCATION				
								"A"	"B"	RETAIN	SALVAGE FROM	SALVAGE TO	REMOVE	RETAIN		REMOVE	1.75	2.00	2.50	FOUNDATION	3.00	3.50			4.00	5.00	SHSM	SIGN DETAILS SHEET #	STANDARD SHEET #
																	(LB / FT)				(LB / FT)								
<b>SB CLARENDON VT ROUTE 103</b>							FY-FLUORESCENT YELLOW FYG-FLUORESCENT YELLOW GREEN															"SHSM"-STANDARD HIGHWAY SIGNS AND MARKINGS BOOK							
SB	1.124	G	VR-023b				 10/16/17					1	X										INSTALL ON RETAINED POST			T-70			
		G	VR-023b	24	30																								
SB	0.774	F	VW-205				 10/16/17					1	X										INSTALL ON RETAINED POST			T-82			
		F	VW-205	36	36																								
SB	0.678	FE	D3-1									2		X															
		FE	D3-1	42	12		 10/17/17								1											8			
SB	0.620	FE	D3-1									1		X															
		FE	D3-1	42	12		 10/17/17								1											8			
SB	0.308	F	W2-7L				 10/17/17					1	X										INSTALL ON RETAINED POST			2			
		F		30	30																								
SB	0.138	G	VR-017									1	X																
		G	R2-1									1																	
		G	VR-079	24	30		 10/16/17																	INSTALL ON RETAINED POST			T-71		
<b>SIGN SUMMARY SHEET</b>							<b>SHEET TOTALS</b>		32.25	0.00	0	0	0	5	0	0	2	30.0	0	0.0	0.0	0.0	0.0	PROJECT NAME: STATEWIDE-SOUTH REGION					
									SF	SF	EA	EA	EA	EA	EA	EA	EA	FT	EA	LB	LB	LB	LB	PROJECT NUMBER: STPG SIGN(57)					
VERMONT AGENCY OF TRANSPORTATION							<b>TOWN DIRECTIONAL TOTALS</b>		142.7	0.0	4	1	1	34	0	0	13	185.0	0		0.0			FILE NAME: z16t041Clarendon103 SB.xls PLOT DATE: 2/27/2017					
																							PROJECT MANAGER: D. MUNRO DRAWN BY: W. GORDON						
																							DESIGNED BY: P. MCKECHNIE CHECKED: BRZEZOWSK						
																							CLARENDON VT-103 SB 5 SHEET 147 OF 264						