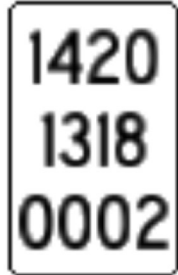


DIRECTION	MILEPOINT	LOCATION CODE (SHEET 4)	SIGN CODE	WIDTH (IN)	HEIGHT (IN)	SHEETING REMARKS	SIGN LEGEND	NEW SIGNS		EXISTING SIGNS				EXIST POST		NUMBER OF NEW POSTS	SQUARE STEEL (IN)			TUBULAR STEEL Ø (IN)				SIGN FRAME REQUIRED	REMARKS	SIGN DETAIL LOCATION				
								"A"	"B"	RETAIN	SALVAGE FROM	SALVAGE TO	REMOVE	RETAIN	REMOVE		1.75	2.00	2.50	FOUNDATION	3.00	3.50	4.00			5.00	SHSM	SIGN DETAILS SHEET #	STANDARD SHEET #	
																	(LB / FT)				(LB / FT)									
																	1.88	2.42	3.35		7.60	9.00	10.80			14.60				
NB VERNON VT ROUTE 142							FY-FLUORESCENT YELLOW FYG-FLUORESCENT YELLOW GREEN															"SHSM"-STANDARD HIGHWAY SIGNS AND MARKINGS BOOK								
NB	0.000	C	VR-017				LLL 24,000 LBS								X								OLD DEPOT RD (TH-23)							
		C	R2-1				SPEED LIMIT 25				1		1										SALVAGE SIGN ON NEW POST AT SAME STATION BELOW LEGAL LOAD							
		C	VR-017	24	30	 11/14/17		5.00								1	14'-6" X						INSTALL NEW POST 10' WEST OF GUY WIRE			T-70				
		C	R2-1				SPEED LIMIT 25				1																			
NB	0.006	D	R1-1				 11/14/17						1		X								OLD DEPOT RD (TH-23)							
		D	R1-1	30	30			6.25								1	13'-6" X							X						
NB	0.006	A	VD-700				MILE MARKER 1420 / 1318 / 0000						1		X															
NB	0.006	A	VR-039				STATE HIGHWAY BEGINS						1		X															
		B	VR-038				STATE HIGHWAY ENDS						1																	
		A	R2-1				SPEED LIMIT 40						1																	
		A	VR-039	24	18	  11/14/17		3.00								1	14'-0" X									T-71				
		B	VR-038	24	18	 11/14/17		3.00															INSTALL BACK TO BACK WITH STATE HIGHWAY BEGINS			T-71				
		A	R2-1	24	30			5.00																X						
		A	VD-700	6	10	 - 4/9/18		0.42																		T-44				
NB	0.008	AB					OLD DEPOT RD						1		X															
SIGN SUMMARY SHEET							SHEET TOTALS	22.67	0.00	0	1	1	7	0	0	3	45.0			0	0.0	0.0	0.0	0.0	PROJECT NAME: STATEWIDE-SOUTH REGION					
								SF	SF	EA	EA	EA	EA	EA	EA	EA		FT		EA	LB	LB	LB	LB	PROJECT NUMBER: STPG SIGN(57)					
																											FILE NAME: z16t041Vernon142 NB.xls	PLOT DATE: 2/27/2017		
							VERMONT AGENCY OF TRANSPORTATION							TOWN DIRECTIONAL TOTALS	615.1	0.0	21	16	16	132	0	0	110	1630.0			0	0.0		