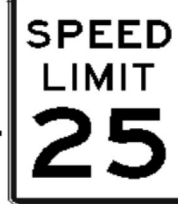


DIRECTION	MILEPOINT	LOCATION CODE (SHEET 4)	SIGN CODE	WIDTH (IN)	HEIGHT (IN)	SHEETING REMARKS	SIGN LEGEND	NEW SIGNS		EXISTING SIGNS				EXIST POST		NUMBER OF NEW POSTS	SQUARE STEEL (IN)			TUBULAR STEEL Ø (IN)				SIGN FRAME REQUIRED	REMARKS	SIGN DETAIL LOCATION			
								"A"	"B"	RETAIN	SALVAGE FROM	SALVAGE TO	REMOVE	RETAIN	REMOVE		1.75	2.00	2.50	FOUNDATION	3.00	3.50	4.00			5.00	SHSM	SIGN DETAILS SHEET #	STANDARD SHEET #
																	(LB / FT)				(LB / FT)								
																	1.88	2.42	3.35		7.60	9.00	10.80			14.60			
NB VERNON VT ROUTE 142							FY-FLUORESCENT YELLOW FYG-FLUORESCENT YELLOW GREEN															"SHSM"-STANDARD HIGHWAY SIGNS AND MARKINGS BOOK							
		D	R1-1	30	30		 11/15/17	6.25							1		13'-3" X								X				
NB	1.645-1.680	A	N/A				 4/9/18 INSTALL (3) NEW DELINEATOR POSTS REMOVE (3) DELINEATOR POSTS																INSTALL (6) TYPE 1 WHITE DELINEATORS BACK TO BACK ON 3 NEW POSTS. INSTALL NEW POSTS IN THE SAME LOCATION AS EXISTING			T-40			
NB	1.755	A	W1-2L				 11/15/17						1		X														
		A	W1-2L	30	30	FY		6.25							1		15'-0" X								X				
NB	2.492	C	VR-017				LLL 24,000 LBS						1		X														
		C	R2-1				SPEED LIMIT 25						1																
		C	VR-017	24	30		 11/15/17	5.00															INSTALL ON RETAINED POST BLODGETT RD (TH-15)			T-70			
		C	R2-1	18	24		 11/17/17	3.00															STICKER ON BACK OF SIGN SHALL READ "VERNON" NOT "VAOT"	X					
NB	2.503	AB					BLODGETT RD						1		X														
		D	R1-1				STOP						1																
		C	VD-700				MILE MARKER 1420 / 1318 / 0250				1		1																
		AB	D3-1	42	12		 11/17/17	3.50							1		13'-3" X						INSTALL ON TOP OF STOP SIGN		8				
		D	R1-1	30	30		 11/15/17	6.25																	X				
		C	VD-700	6	10		MILE MARKER 1420 / 1318 / 0250	6.42				1											INSTALL SALVAGED MILE MARKER BACK TO BACK ON STOP SIGN POST						
NB	2.618	A					REDUCED SPEED AHEAD						1		X														
SIGN SUMMARY SHEET							SHEET TOTALS		30.67	0.00	0	1	1	7	0	0	3	45.0			0	0.0	0.0	0.0	0.0	PROJECT NAME: STATEWIDE-SOUTH REGION			
									SF	SF	EA	EA	EA	EA	EA	EA	EA	FT			EA	LB	LB	LB	LB	PROJECT NUMBER: STPG SIGN(57)			
																						EA	LB	LB	LB	LB	FILE NAME: z16t041Vernon142 NB.xls		
							VERMONT AGENCY OF TRANSPORTATION		TOWN DIRECTIONAL TOTALS		615.1	0.0	21	16	16	132	0	0	110	1630.0			0	0.0				PLOT DATE: 2/27/2017	
																							DRAWN BY: W. GORDON						
																							CHECKED: BRZEZOWSKI						
																							SHEET 155 OF 264						