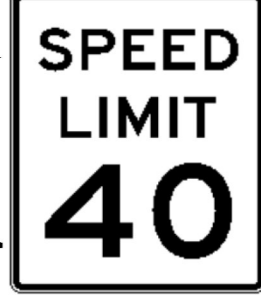


DIRECTION	MILEPOINT	LOCATION CODE (SHEET 4)	SIGN CODE	WIDTH (IN)	HEIGHT (IN)	SHEETING REMARKS	SIGN LEGEND	NEW SIGNS		EXISTING SIGNS				EXIST POST		NUMBER OF NEW POSTS	SQUARE STEEL (IN)			TUBULAR STEEL Ø (IN)				SIGN FRAME REQUIRED	REMARKS	SIGN DETAIL LOCATION			
								"A"	"B"	RETAIN	SALVAGE FROM	SALVAGE TO	REMOVE	RETAIN	REMOVE		1.75	2.00	2.50	FOUNDATION	3.00	3.50	4.00			5.00	SHSM	SIGN DETAILS SHEET #	STANDARD SHEET #
																	(LB / FT)				(LB / FT)								
																	1.88	2.42	3.35		7.60	9.00	10.80			14.60			
NB VERNON VT ROUTE 142							FY-FLUORESCENT YELLOW FYG-FLUORESCENT YELLOW GREEN															"SHSM"-STANDARD HIGHWAY SIGNS AND MARKINGS BOOK							
NB	2.625	A	W3-5	36	36		 11/21/17	9.00								2		X						INSTALL SIGN ±35' DOWNSTATION FROM EXISTING SIGN AT MP 2.618 NB	X				
NB	2.745	A	R2-1				 11/17/17					1		X															
		A	R2-1	30	36			7.50								1		14'-3" X							X				
NB	2.800	A	W1-2L										1		X														
NB	2.828	AB					 11/17/17					1		X															
		AB	D3-1	42	12			3.50								1		11'-0" X						STEBBINS RD (TH-5)		8			
NB	2.840	C	VR-017								1	1	1		X	1		10'-3" X						REPLACE BENT POST AT SAME STATION. SALVAGE SIGN TO NEW POST ANCHOR REUSED					
NB	2.850	D	R1-1								1	1	1		X	1		10'-3" X						REPLACE BENT POST AT SAME STATION. SALVAGE SIGN TO NEW POST ANCHOR REUSED					
NB	2.854	AB	VR-020										2		X														
		A	VR-020	24	30		  11/17/17	5.00									1		13'-0" X							T-70			
		B	VR-020	24	30			5.00																BACK TO BACK		T-70			
NB	3.055	A											1		X														
		A	R2-1	24	30		 11/17/17	5.00								1		13'-6" X							X				
NB	3.093	A	R2-1										1		X														
NB	3.130	A	W11-8										1		X														
SIGN SUMMARY SHEET						SHEET TOTALS		35.00	0.00	0	2	2	10	0	0	8		120.0	0	0.0	0.0	0.0	0.0	PROJECT NAME: STATEWIDE-SOUTH REGION					
								SF	SF	EA	EA	EA	EA	EA	EA	EA		FT	EA	LB	LB	LB	LB	PROJECT NUMBER: STPG SIGN(57)					
																								FILE NAME: z16t041Vernon142 NB.xls					
						VERMONT AGENCY OF TRANSPORTATION		TOWN DIRECTIONAL TOTALS		615.1	0.0	21	16	16	132	0	0	110		1630.0	0	0.0				PLOT DATE: 2/27/2017			
																						DRAWN BY: W. GORDON							
																						CHECKED: BRZEWOWSKI							
																						SHEET 156 OF 264							