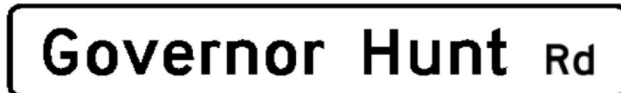
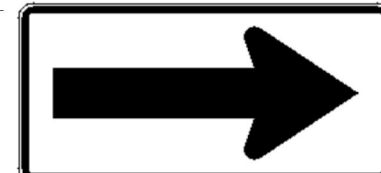


DIRECTION	MILEPOINT	LOCATION CODE (SHEET 4)	SIGN CODE	WIDTH (IN)	HEIGHT (IN)	SHEETING REMARKS	SIGN LEGEND	NEW SIGNS		EXISTING SIGNS				EXIST POST		NUMBER OF NEW POSTS	SQUARE STEEL (IN)			TUBULAR STEEL Ø (IN)				SIGN FRAME REQUIRED	REMARKS	SIGN DETAIL LOCATION				
								"A"	"B"	RETAIN	SALVAGE FROM	SALVAGE TO	REMOVE	RETAIN	REMOVE		1.75	2.00	2.50	FOUNDATION	3.00	3.50	4.00			5.00	SHSM	SIGN DETAILS SHEET #	STANDARD SHEET #	
																	(LB / FT)				(LB / FT)									
																	1.88	2.42	3.35		7.60	9.00	10.80			14.60				
NB VERNON VT ROUTE 142							FY-FLUORESCENT YELLOW FYG-FLUORESCENT YELLOW GREEN															"SHSM"-STANDARD HIGHWAY SIGNS AND MARKINGS BOOK								
NB	5.190	A					FLASHING BEACON			1				X																
		A	W10-1				 11/17/17																							
		A	W10-1	36	36			7.07																		INSTALL NEW SIGN ON RETAINED POST WITH EXISTING CONDUIT 36" DIAMATER	X			
NB	5.240	A	W1-10cL										1		X															
		A	W13-1P										1																	
		A	W1-10cL	36	36		 11/17/17	9.00										17'-3" X									X			
		A	W13-1P	24	24		 11/17/17	4.00																		INSTALL ON LEFT POST	X			
NB	5.310	A	W11-4	30	30		 11/17/17	6.25										15'-9" X								INSTALL ±85' DOWNSTATION FROM EXISTING SIGN AT MP 5.326 NB	X			
			VW11-4P	30	18		 CATTLE CROSSING	3.75																				5		
NB	5.326	C	VR-017				LLL 24,000 LBS			1				X												GOVERNOR HUNT RD (TH-4)				
NB	5.326	AB											1		X															
		AB	D3-1	72	12		 11/21/17	6.00										12'-3" X										8		
NB	5.326	B	W1-6				ONE DIRECTION LARGE ARROW						1		X															
		B	VD-700				MILE MARKER 1420 / 1318 / 0537				1		1													SALVAGE MILE MARKER TO MP 5.340 NB				
NB	5.326	B	W1-6	48	24		 11/17/17	8.00										14'-6" X									X			
SIGN SUMMARY SHEET							SHEET TOTALS		44.07	0.00	2	1	0	6	0	0	7	105.0			0	0.0	0.0	0.0	0.0	PROJECT NAME: STATEWIDE-SOUTH REGION				
									SF	SF	EA	EA	EA	EA	EA	EA	EA	FT			EA	LB	LB	LB	LB	PROJECT NUMBER: STPG SIGN(57)				
																						EA	LB	LB	LB	LB	FILE NAME: z16t041Vernon142 NB.xls			
							VERMONT AGENCY OF TRANSPORTATION		TOWN DIRECTIONAL TOTALS										615.1	0.0	21	16	16	132	0	0	110	1630.0		
																									DRAWN BY: W. GORDON					
																									CHECKED: BRZEZOWSKI					
																									VERNON VT-142 NB 14			SHEET 162 OF 264		