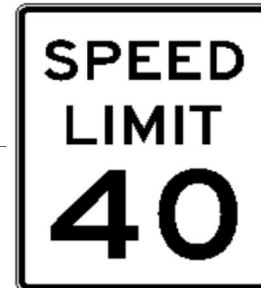


DIRECTION	MILEPOINT	LOCATION CODE (SHEET 4)	SIGN CODE	WIDTH (IN)	HEIGHT (IN)	SHEETING REMARKS	SIGN LEGEND	NEW SIGNS		EXISTING SIGNS				EXIST POST		NUMBER OF NEW POSTS	SQUARE STEEL (IN)			TUBULAR STEEL Ø (IN)				SIGN FRAME REQUIRED	REMARKS	SIGN DETAIL LOCATION			
								"A"	"B"	RETAIN	SALVAGE FROM	SALVAGE TO	REMOVE	RETAIN	REMOVE		1.75	2.00	2.50	FOUNDATION	3.00	3.50	4.00			5.00	SHSM	SIGN DETAILS SHEET #	STANDARD SHEET #
																	(LB / FT)				(LB / FT)								
																	1.88	2.42	3.35		7.60	9.00	10.80			14.60			
NB VERNON VT ROUTE 142							FY-FLUORESCENT YELLOW FYG-FLUORESCENT YELLOW GREEN															"SHSM"-STANDARD HIGHWAY SIGNS AND MARKINGS BOOK							
		A	VD-700				MILE MARKER 1420 / 1318 / 0760				1		1																
NB	7.610	A	W11-1	30	30			6.25							1		17'-3" X							INSTALL SIGN ±350' UPSTATION FROM EXISTING SIGN AT MP 7.544 NB	X				
		A	W16-1P	18	24			3.00																	X				
		A	VD-700				MILE MARKER 1420 / 1318 / 0760					1																	
NB	7.850	A	W11-2				PEDESTRIAN TRAFFIC						1		X														
		A	VW-207BP				BLIND PERSON (PLAQUE)						1																
		A	W7-3aP				NEXT 1/2 MILE						1																
		A	W11-2	30	30	FYG		6.25							1		16'-9" X							INSTALL NEW POST IN SAME LOCATION BEHIND GUARDRAIL	X				
		A	VW-207BP	24	18	FYG		3.00																	5				
		A	W7-3aP	24	18	FYG		3.00																	X				
NB	7.890	A	W3-5										1		X														
		A	W3-5	36	36			9.00																INSTALL ON RETAINED POSTS	X				
NB	8.005	A	R2-1				SPEED LIMIT 40						1		X														
		A	VD-700									1	1																
		A	R2-1	30 24	36 30			7.50 5.00							1		13'-0" X								X				
SIGN SUMMARY SHEET						SHEET TOTALS		35.50	0.00	0	2	1	7	0	0	3		45.0	0	0.0	0.0	0.0	0.0	PROJECT NAME: STATEWIDE-SOUTH REGION					
								SF	SF	EA	EA	EA	EA	EA	EA	EA		FT	EA	LB	LB	LB	LB	PROJECT NUMBER: STPG SIGN(57)					
																		FILE NAME: z16t041Vernon142 NB.xls										PLOT DATE: 2/27/2017	
																		PROJECT MANAGER: D. MUNRO										DRAWN BY: W. GORDON	
VERMONT AGENCY OF TRANSPORTATION						TOWN DIRECTIONAL TOTALS		615.1	0.0	21	16	16	132	0	0	110		1630.0	0		0.0		DESIGNED BY: P. MCKECHNIE			CHECKED: BRZEWOSKI			
																							VERNON VT-142 NB 17			SHEET 165 OF 264			