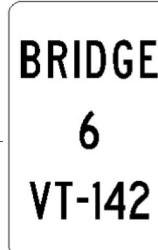


DIRECTION	MILEPOINT	LOCATION CODE (SHEET 4)	SIGN CODE	WIDTH (IN)	HEIGHT (IN)	SHEETING REMARKS	SIGN LEGEND	NEW SIGNS		EXISTING SIGNS				EXIST POST		NUMBER OF NEW POSTS	SQUARE STEEL (IN)			TUBULAR STEEL Ø (IN)				SIGN FRAME REQUIRED	REMARKS	SIGN DETAIL LOCATION			
								"A"	"B"	RETAIN	SALVAGE FROM	SALVAGE TO	REMOVE	RETAIN	REMOVE		1.75	2.00	2.50	FOUNDATION	3.00	3.50	4.00			5.00	SHSM	SIGN DETAILS SHEET #	STANDARD SHEET #
																	(LB / FT)				(LB / FT)								
																	1.88	2.42	3.35		7.60	9.00	10.80			14.60			
SB VERNON VT ROUTE 142							FY-FLUORESCENT YELLOW FYG-FLUORESCENT YELLOW GREEN															"SHSM"-STANDARD HIGHWAY SIGNS AND MARKINGS BOOK							
SB	8.610	F	W1-4R				 11/14/17							1		X													
SB	8.595	F	W1-4R	30	30			6.25							1		13'-0" X								INSTALL ±80' DOWNSTATION FROM EXISTING SIGN AT MP 8.610 SB	X			
SB	8.460	F	W11-2				PEDESTRIAN TRAFFIC							1		X													
		F	VW-207BP				BLIND PERSON (PLAQUE)							1															
		F	W7-3aP				NEXT 1/2 MILE							1															
		F	W11-2	30	30	FYG	 BLIND PERSON	6.25							1	2	15'-0" X									X			
		F	VW-207BP	24	18	FYG	NEXT 1/2 MILE	3.00																		5			
		F	W7-3aP	24	18	FYG		3.00																		X			
SB	8.290	G	VR-017	24	30		 11/14/17	5.00							1		13'-6" X								INSTALL ON LEGAL LOAD SIDE OF ROAD			T-70	
SB	8.282	H	R1-1				11/14/17 STOP				1	1	1		X	1	12'-3" X								BROAD BROOK RD (TH-6); INSTALL NEW POST AT MINIMUM 4' OFFSET FROM FACE OF RAIL				
SB	8.282	FE	D3-1				Broad Brook Rd			1				X															
SB	8.266	F	VD-701				 4/9/18							1		X													
		F	VD-701	6	10			0.42							1		8'-9" X											T-42	
SB	8.265	F	OM3-R				 11/14/17							1		X													
		F	OM3-R	12	36			3.00							1		10'-9" X									X			
SIGN SUMMARY SHEET							SHEET TOTALS		26.92	0.00	1	1	1	7	0	0	7		100.0		0	0.0	0.0	0.0	0.0	PROJECT NAME: STATEWIDE-SOUTH REGION			
									SF	SF	EA	EA	EA	EA	EA	EA	EA		FT		EA	LB	LB	LB	LB	PROJECT NUMBER: STPG SIGN(57)			
																										FILE NAME: z16t041Vernon142 SB.xls			
																										PLOT DATE: 2/27/2017			
VERMONT AGENCY OF TRANSPORTATION							TOWN DIRECTIONAL TOTALS		485.1	0.0	14	12	12	104	0	0	88		1310.0		0	0.0				DRAWN BY: W. GORDON			
																											CHECKED: BRZEWOSKI		
																										DESIGNED BY: P. MCKECHNIE			
																										VERNON VT-142 SB 1			
																										SHEET 169 OF 264			