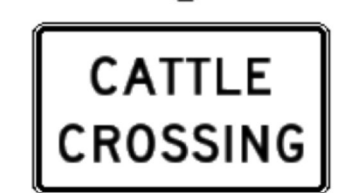


DIRECTION	MILEPOINT	LOCATION CODE (SHEET 4)	SIGN CODE	WIDTH (IN)	HEIGHT (IN)	SHEETING REMARKS	SIGN LEGEND	NEW SIGNS		EXISTING SIGNS				EXIST POST		NUMBER OF NEW POSTS	SQUARE STEEL (IN)			TUBULAR STEEL Ø (IN)				SIGN FRAME REQUIRED	REMARKS	SIGN DETAIL LOCATION			
								"A"	"B"	RETAIN	SALVAGE FROM	SALVAGE TO	REMOVE	RETAIN	REMOVE		1.75	2.00	2.50	FOUNDATION	3.00	3.50	4.00			5.00	SHSM	SIGN DETAILS SHEET #	STANDARD SHEET #
																	(LB / FT)				(LB / FT)								
																	1.88	2.42	3.35		7.60	9.00	10.80			14.60			
SB VERNON VT ROUTE 142							FY-FLUORESCENT YELLOW FYG-FLUORESCENT YELLOW GREEN															"SHSM"-STANDARD HIGHWAY SIGNS AND MARKINGS BOOK							
SB	5.900	G	VR-017				LLL 24,000 LBS			1				X									HUBBARD RD (TH-26)						
SB	5.900	FE	D3-1				11/15/17 Hubbard Rd					1				12'-0" X							SALVAGE TO LEGAL LOAD SIDE OF INTERSECTION						
SB	5.890	FE	D3-1				Hubbard Rd				1		1	X															
		H	R1-1				STOP			1																			
SB	5.835	F	W1-4L				 11/15/17 LEFT REVERSE CURVE					1		X															
		F	S3-1	36	36	FYG	 7/12/18	9.00								2	14'-9" 14'-0" X								X				
SB	5.730	F	W11-5									1	X	X															
		F	W11-5	30	30			6.25							1	14'-0" X								INSTALL ON RETAINED POST	X				
SB	5.655	FE	D3-1				Tyler Hill Rd			1				X									TYLER HILL RD (TH-1)						
SB	5.655	G	VR-017				LLL 24,000 LBS			1				X															
SB	5.645	H	R1-1				11/15/17 STOP				1	1	1		X	1	14'-3" X							SALVAGE SIGN TO NEW POST AT SAME STATION					
SB	5.562	F	W11-4				CATTLE TRAFFIC						1		X														
		F					 11/15/17 CATTLE CROSSING (PLAQUE)																						
		F	W11-4	30	30			6.25								1	16'-0" X								X				
		F	VW11-4P	30	18			3.75																	5				
SIGN SUMMARY SHEET						SHEET TOTALS		25.25	0.00	4	2	2	6	0	0	5	75.0		0	0.0	0.0	0.0	0.0	PROJECT NAME: STATEWIDE-SOUTH REGION					
								SF	SF	EA	EA	EA	EA	EA	EA	EA	FT		EA	LB	LB	LB	LB	PROJECT NUMBER: STPG SIGN(57)					
																								FILE NAME: z16t041Vernon142 SB.xls					
VERMONT AGENCY OF TRANSPORTATION						TOWN DIRECTIONAL TOTALS		485.1	0.0	14	12	12	104	0	0	88	1310.0		0	0.0				PLOT DATE: 2/27/2017					
																								DRAWN BY: W. GORDON					
																								CHECKED: BRZEZOWSKI					
																								SHEET 172 OF 264					