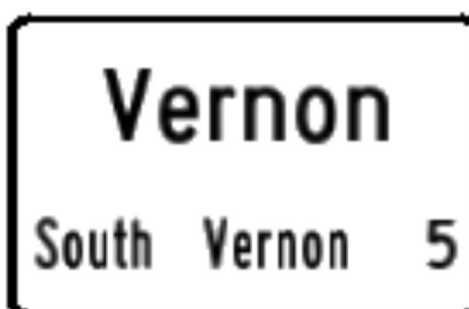


DIRECTION	MILEPOINT	LOCATION CODE (SHEET 4)	SIGN CODE	WIDTH (IN)	HEIGHT (IN)	SHEETING REMARKS	SIGN LEGEND	NEW SIGNS		EXISTING SIGNS				EXIST POST		NUMBER OF NEW POSTS	SQUARE STEEL (IN)			TUBULAR STEEL Ø (IN)				SIGN FRAME REQUIRED	REMARKS	SIGN DETAIL LOCATION			
								"A"	"B"	RETAIN	SALVAGE FROM	SALVAGE TO	REMOVE	RETAIN	REMOVE		1.75	2.00	2.50	FOUNDATION	3.00	3.50	4.00			5.00	SHSM	SIGN DETAILS SHEET #	STANDARD SHEET #
																	(LB / FT)				(LB / FT)								
																	1.88	2.42	3.35		7.60	9.00	10.80			14.60			
SB VERNON VT ROUTE 142							FY-FLUORESCENT YELLOW FYG-FLUORESCENT YELLOW GREEN															"SHSM"-STANDARD HIGHWAY SIGNS AND MARKINGS BOOK							
SB	5.515	F	W10-1				 11/15/17						1	X															
		F	W10-1	36	36			7.07																36" DIAMETER INSTALL ON RETAINED POST	X				
SB	5.470	F	W1-10b				 11/15/17						1		X														
		F	W13-1P										1																
		F	W1-10b	36	36				9.00								2	14'-6" 14'-6" X								X			
		F	W13-1P	24	24				4.00																INSTALL ON LEFT POST	X			
SB	5.405	F	R15-1				RAILROAD CROSS BUCK (ON MAST ARM)			1				X															
SB	5.320	F	M3-3	24	12		 11/15/17	2.00								1	15'-9" X								INSTALL ±420' UPSTATION FROM SIGN AT MP 5.240 SB SOUTH, GREEN ON WHITE	X			
		F	VM1-5	30	24			5.00																			E-136		
SB	5.240	F	M3-3				SOUTH						1		X														
		F	VM1-5				VERMONT 142						1																
		F	VD-018A	36	24	 11/15/17		6.00								1	14'-0" X							INSTALL IN SAME LOCATION AS EXISTING ROUTE MARKER SIGN			T-95		
SB	5.155	FE	D3-1				PECK RD PVT						1		X														
SB	5.130	FE	D3-1	42	12	 11/15/17		3.50								1	11'-0" X							INSTALL MINIMUM 10' FROM UTILITY POLE ON SOUTH SIDE OF INTERSECTION		8			
SB	5.155	G	R1-1				STOP			1				X															
SIGN SUMMARY SHEET						SHEET TOTALS		36.57	0.00	2	0	0	6	0	0	5	75.0			0	0.0	0.0	0.0	0.0	PROJECT NAME: STATEWIDE-SOUTH REGION				
								SF	SF	EA	EA	EA	EA	EA	EA	EA	FT			EA	LB	LB	LB	LB	PROJECT NUMBER: STPG SIGN(57)				
																								FILE NAME: z16t041Vernon142 SB.xls					
VERMONT AGENCY OF TRANSPORTATION						TOWN DIRECTIONAL TOTALS		485.1	0.0	14	12	12	104	0	0	88	1310.0			0	0.0				PLOT DATE: 2/27/2017				
																								DRAWN BY: W. GORDON					
																						CHECKED: BRZEZOWSKI							
																						DESIGNED BY: P. MCKECHNIE							
																						VERNON VT-142 SB 5							
																						SHEET 173 OF 264							