

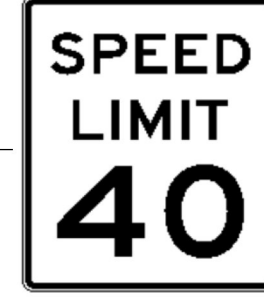




DIRECTION	MILEPOINT	LOCATION CODE (SHEET 4)	SIGN CODE	WIDTH (IN)	HEIGHT (IN)	SHEETING REMARKS	SIGN LEGEND	NEW SIGNS		EXISTING SIGNS			EXIST POST		NUMBER OF NEW POSTS	SQUARE STEEL (IN)			TUBULAR STEEL Ø (IN)				SIGN FRAME REQUIRED	REMARKS	SIGN DETAIL LOCATION				
								"A"	"B"	RETAIN	SALVAGE FROM	SALVAGE TO	REMOVE	RETAIN		REMOVE	1.75	2.00	2.50	FOUNDATION	3.00	3.50			4.00	5.00	SHSM	SIGN DETAILS SHEET #	STANDARD SHEET #
																	(LB / FT)				(LB / FT)								
<b>SB VERNON VT ROUTE 142</b>							FY-FLUORESCENT YELLOW FYG-FLUORESCENT YELLOW GREEN															"SHSM"-STANDARD HIGHWAY SIGNS AND MARKINGS BOOK							
SB	4.785	FE	D3-1				BEMIS RD PVT																						
		F	VD-700				MILE MARKER 1420 / 1318 / 0480			1																			
		FE	D3-1	56	12		 11/15/17	4.67																8					
		F	VD-700				MILE MARKER 1420 / 1318 / 0480				1												INSTALL SALVAGED MILE MARKER ON LEFT POST						
SB	4.715	F	R2-5a				REDUCED SPEED AHEAD																						
		F	W3-5	36	36		 11/15/17	9.00																X					
SB	4.605	F	R2-1				 11/15/17																						
		F	R2-1	30	36			7.50																X					
SB	4.554	FE	D3-1				Rinfret Rd PVT																						
		FE	D3-1	42	12		 11/15/17	3.50																	9				
SB	4.525	F	W11-1				 11/16/17																						
		F	W16-1P																										
		F	W11-1	30	30			6.25																X					
		F	W16-1P	18	24			3.00																X					
SB	4.375	F	W1-10c				CURVE WARNING / SIDEROAD																						
<b>SIGN SUMMARY SHEET</b>							<b>SHEET TOTALS</b>	33.92	0.00	0	1	1	8	0	0	7	105.0	0	0.0	0.0	0.0	0.0	PROJECT NAME: STATEWIDE-SOUTH REGION PROJECT NUMBER: STPG SIGN(57)						
VERMONT AGENCY OF TRANSPORTATION							<b>TOWN DIRECTIONAL TOTALS</b>	485.1	0.0	14	12	12	104	0	0	88	1310.0	0		0.0			FILE NAME: z16t041Vernon142 SB.xls PROJECT MANAGER: D. MUNRO DESIGNED BY: P. MCKECHNIE VERNON VT-142 SB 6						
																						PLOT DATE: 2/27/2017 DRAWN BY: W. GORDON CHECKED: BRZEZOWSK SHEET 174 OF 264							