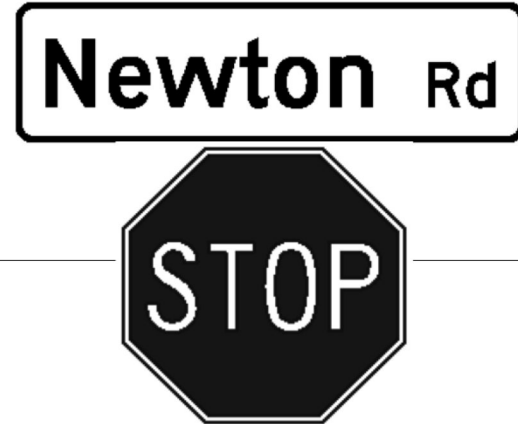


DIRECTION	MILEPOINT	LOCATION CODE (SHEET 4)	SIGN CODE	WIDTH (IN)	HEIGHT (IN)	SHEETING REMARKS	SIGN LEGEND	NEW SIGNS		EXISTING SIGNS				EXIST POST		NUMBER OF NEW POSTS	SQUARE STEEL (IN)			TUBULAR STEEL Ø (IN)				SIGN FRAME REQUIRED	REMARKS	SIGN DETAIL LOCATION			
								"A"	"B"	RETAIN	SALVAGE FROM	SALVAGE TO	REMOVE	RETAIN	REMOVE		1.75	2.00	2.50	FOUNDATION	3.00	3.50	4.00			5.00	SHSM	SIGN DETAILS SHEET #	STANDARD SHEET #
																	(LB / FT)				(LB / FT)								
																	1.88	2.42	3.35		7.60	9.00	10.80			14.60			
SB VERNON VT ROUTE 142							FY-FLUORESCENT YELLOW FYG-FLUORESCENT YELLOW GREEN															"SHSM"-STANDARD HIGHWAY SIGNS AND MARKINGS BOOK							
		H	R1-1				STOP				1		1										SALVAGE SIGN TO NEW POST AT SAME LOCATION						
		H	R1-1				11/16/17 STOP					1				12'-3" X													
SB	2.105	G	VR-017	24	30		 4/9/18	5.00							1		X						INSTALL 50' UP NEWTON RD BEYOND EXISTING LEGAL LOAD SIGN.			T-70			
SB	2.095	FE	D3-1									1		X															
		H	R2-1										1																
		FE	D3-1	42	12		 11/16/17	3.50							1		13'-3" X						INSTALL ON TOP OF STOP SIGN		8				
		H	R2-1	30	30			6.25																X					
SB	2.075	F	W12-2										1		X														
		F											1																
SB	2.060	F	W12-2	36	36	FY		9.00								2		17'-6" 14'-3" X					INSTALL 80' DOWNSTATION FROM EXISTING SIGN	X					
		F		30	24	FY	 11/21/17	5.00																	5				
SB	1.940	F	W1-2R				 11/15/17						1		X														
		F	W11-1	30	30			6.25								1		15'-0" X					INSTALL BICYCLE WARNING SIGN IN PLACE OF EXISTING RIGHT CURVE WARNING	X					
		F	W16-1P	18	24		 11/16/17	3.00																X					
SB	1.895	F	W1-2R	30	30		 11/16/17	6.25								1		11'-6" X					INSTALL SIGN 50' UPSTATION FROM EXISTING BICYCLE SIGN AT MP 1.885 SB	X					
SIGN SUMMARY SHEET						SHEET TOTALS		44.25	0.00	0	1	1	6	0	0	7	105.0		0	0.0	0.0	0.0	0.0	PROJECT NAME: STATEWIDE-SOUTH REGION					
								SF	SF	EA	EA	EA	EA	EA	EA	EA	FT			EA	LB	LB	LB	LB	PROJECT NUMBER: STPG SIGN(57)				
																										FILE NAME: z16t041Vernon142 SB.xls	PLOT DATE: 2/27/2017		
						VERMONT AGENCY OF TRANSPORTATION																				DESIGNED BY: P. MCKECHNIE	DRAWN BY: W. GORDON		
						TOWN DIRECTIONAL TOTALS		485.1	0.0	14	12	12	104	0	0	88	1310.0		0	0.0				CHECKED BRZEZOWSKI		SHEET 178 OF 264			