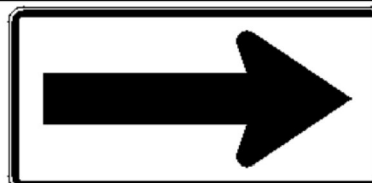


DIRECTION	MILEPOINT	LOCATION CODE (SHEET 4)	SIGN CODE	WIDTH (IN)	HEIGHT (IN)	SHEETING REMARKS	SIGN LEGEND	NEW SIGNS		EXISTING SIGNS				EXIST POST		NUMBER OF NEW POSTS	SQUARE STEEL (IN)			TUBULAR STEEL Ø (IN)				SIGN FRAME REQUIRED	REMARKS	SIGN DETAIL LOCATION			
								"A"	"B"	RETAIN	SALVAGE FROM	SALVAGE TO	REMOVE	RETAIN	REMOVE		1.75	2.00	2.50	FOUNDATION	3.00	3.50	4.00			5.00	SHSM	SIGN DETAILS SHEET #	STANDARD SHEET #
																	(LB / FT)				(LB / FT)								
																	1.88	2.42	3.35		7.60	9.00	10.80			14.60			
SB VERNON VT ROUTE 142							FY-FLUORESCENT YELLOW FYG-FLUORESCENT YELLOW GREEN															"SHSM"-STANDARD HIGHWAY SIGNS AND MARKINGS BOOK							
		F	W12-2	36	36	FY	 11/15/17	9.00								2	11'-9" 10'-6" X							THINNING & TRIMMING	X				
SB	1.145	F	OM3-R				 11/15/17						1		X														
		F	OM3-R	12	36	FY		3.00								1	9'-9" X									X			
SB	1.132	E	OM3-L				 11/15/17						1		X														
		E	OM3-L	12	36	FY		3.00								1	10'-6" X								X				
SB	1.105	F	W1-6	48	24	FY	 11/17/17	8.00								2	15'-0" 14'-9" X							INSTALL SIGN ±105 UPSTATION FROM EXISTING SIGN AT MP 1.085 SB	X				
SB	1.085	F	S3-1				 11/17/17						1		X														
		F	S3-1	36	36	FYG		9.00								2	15'-0" 15'-0" X							BUS STOP AT VALLEY VIEW DRIVE	X				
SB	1.073	E	W1-6	48	24	FY	 11/17/17	8.00								2	13'-3" 13'-0" X							INSTALL SIGN ±65' DOWNSTATION FROM EXISTING SIGN AT MO 1.085 SB	X				
SB	0.992	G	VR-017										1	X										VALLEY VIEW DR (TH-37)					
		G	R2-1								1		1																
		G	VR-017	24	30		 11/14/17	5.00																INSTALL ON RETAINED POST			T-70		
		G	R2-1								1													INSTALL BELOW LLL AT SAME LOCATION					
SB	0.983	FE	D3-1	64	12		 11/15/17	5.33								2	11'-6" 11'-0" X							INSTALL INDEPENDENTLY ON TWO POSTS ON STOP SIGN SIDE OF THE INTERSECTION		8			
SIGN SUMMARY SHEET							SHEET TOTALS		50.33	0.00	0	1	1	5	0	0	12		180.0	0	0.0	0.0	0.0	0.0	PROJECT NAME: STATEWIDE-SOUTH REGION				
									SF	SF	EA	EA	EA	EA	EA	EA	EA		FT		EA	LB	LB	LB	LB	PROJECT NUMBER: STPG SIGN(57)			
																									FILE NAME: z16t041Vernon142 SB.xls				
																									PROJECT MANAGER: D. MUNRO				
VERMONT AGENCY OF TRANSPORTATION							TOWN DIRECTIONAL TOTALS		485.1	0.0	14	12	12	104	0	0	88		1310.0	0	0.0				DESIGNED BY: P. MCKECHNIE				
																										VERNON VT-142 SB 12			
																								PLOT DATE: 2/27/2017					
																								DRAWN BY: W. GORDON					
																								CHECKED: BRZEZOWSKI					
																								SHEET 180 OF 264					