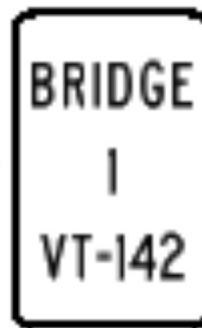


DIRECTION	MILEPOINT	LOCATION CODE (SHEET 4)	SIGN CODE	WIDTH (IN)	HEIGHT (IN)	SHEETING REMARKS	SIGN LEGEND	NEW SIGNS		EXISTING SIGNS				EXIST POST		NUMBER OF NEW POSTS	SQUARE STEEL (IN)			TUBULAR STEEL Ø (IN)				SIGN FRAME REQUIRED	REMARKS	SIGN DETAIL LOCATION									
								"A"	"B"	RETAIN	SALVAGE FROM	SALVAGE TO	REMOVE	RETAIN	REMOVE		1.75	2.00	2.50	FOUNDATION	3.00	3.50	4.00			5.00	SHSM	SIGN DETAILS SHEET #	STANDARD SHEET #						
																	(LB / FT)				(LB / FT)														
																	1.88	2.42	3.35		7.60	9.00	10.80			14.60									
SB VERNON VT ROUTE 142							FY-FLUORESCENT YELLOW FYG-FLUORESCENT YELLOW GREEN															"SHSM"-STANDARD HIGHWAY SIGNS AND MARKINGS BOOK													
		F	W7-3aP				NEXT 3/4 MILE						1																						
		F	W11-4	30	30		 11/15/17	6.25							1		14'-0" X									X									
		F	W7-3aP	24	18		 11/15/17	3.00																		X									
SB	0.730	F					CONNECTICUT RIVER BYWAY			1				X																					
		F	D6-4a				AMERICA'S BYWAYS (PLAQUE)			1																									
SB	0.575	F	VD-701				 11/15/17						1		X																				
		F	VD-701	6	10			0.42								1	8'-3" X												T-42						
SB	0.480	F	W3-5				 11/15/17						1	X																					
		F	W3-5	36	36			9.00																		X									
SB	0.365	F	R2-1				 11/15/17						1		X																				
		F	R2-1	30	36			7.50								1	13'-0" X									X									
SB	0.230	E					PRIVATE COW SIGN						1														RETURN SIGN TO VERMONT FARM LLC AT 4370 FORT BRIDGMAN RD								
SB	0.083	F	M4-6				END						1		X																				
		F	VM5-1				VERMONT 142						1																						
SIGN SUMMARY SHEET							SHEET TOTALS	26.17	0.00	2	0	0	7	0	0	3		40.0		0	0.0	0.0	0.0	0.0	PROJECT NAME: STATEWIDE-SOUTH REGION	PROJECT NUMBER: STPG SIGN(57)			VERMONT AGENCY OF TRANSPORTATION						
								SF	SF	EA	EA	EA	EA	EA	EA	EA		FT		EA	LB	LB	LB	LB											
																															FILE NAME: z16t041Vernon142 SB.xls	PLOT DATE: 2/27/2017			
							TOWN DIRECTIONAL TOTALS	485.1	0.0	14	12	12	104	0	0	88		1310.0		0		0.0								DESIGNED BY: P. MCKECHNIE	DRAWN BY: W. GORDON				
																								CHECKED: BRZEZOWSKI	SHEET 182 OF 264										