






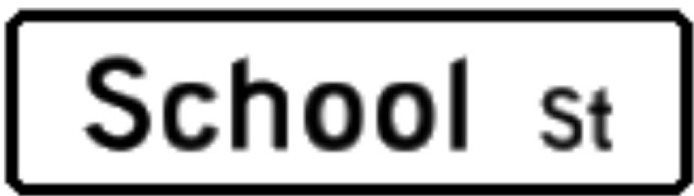

DIRECTION	MILEPOINT	LOCATION CODE (SHEET 4)	SIGN CODE	WIDTH (IN)	HEIGHT (IN)	SHEETING REMARKS	SIGN LEGEND	NEW SIGNS		EXISTING SIGNS			EXIST POST		NUMBER OF NEW POSTS	SQUARE STEEL (IN)			TUBULAR STEEL Ø (IN)				SIGN FRAME REQUIRED	REMARKS	SIGN DETAIL LOCATION				
								"A"	"B"	RETAIN	SALVAGE FROM	SALVAGE TO	REMOVE	RETAIN		REMOVE	1.75	2.00	2.50	3.00	3.50	4.00			5.00	SHSM	SIGN DETAILS SHEET #	STANDARD SHEET #	
																	(LB / FT)			(LB / FT)									
EB WALLINGFORD VT RTE 140							FY-FLUORESCENT YELLOW FYG-FLUORESCENT YELLOW GREEN															"SHSM"-STANDARD HIGHWAY SIGNS AND MARKINGS BOOK							
EB	0.002	CD	D3-1				 11/28/17					1	X										ON PEDESTRIAN SIGNAL POLE. RETAIN BRACKET						
		CD	D3-1	42	12			3.50															INSTALL NEW SIGN ON RETAINED BRACKET		9				
EB	0.008	C	R7-11	12	18			1.50							1		X						INSTALL 30' EAST OF PEDESTRIAN SIGNAL POLE @ 0.002 EB. PROVIDE 7' MINIMUM CLEAR HEIGHT		4				
																													
EB	0.015	C	R7-23A				1 HOUR PARKING 6AM-9PM					1																	
EB	0.020	A	VR-039				STATE HIGHWAY BEGINS					1																	
		B	VR-038				STATE HIGHWAY ENDS					1																	
		A	R2-1				SPEED LIMIT 25					1																	
		A	R2-1	30	36		 10/20/17	7.50							1								PROVIDE 7' MINIMUM CLEAR HEIGHT		X				
EB	0.040	C	R8-3a									1																	
		C					 10/20/17					1																	
EB	0.046	C	R8-3a	24	24		 10/20/17	4.00							1								INSTALL SIGN 30' UPSTATION BEYOND DRIVE AND SEWER MANHOLE		X				
		C		24	10			1.67															PROVIDE 7' MINIMUM CLEAR HEIGHT			4			
EB	0.060	A	S1-1				SCHOOL CROSSING					1	X	X															
		A	W16-9p				AHEAD PLAQUE					1																	
		A	S1-1	30	30	FYG	 10/20/17	6.25							1								PROVIDE 7' MINIMUM CLEAR HEIGHT. INSTALL ON RETAINED POST		X				
SIGN SUMMARY SHEET							SHEET TOTALS					24.42	0.00	0	0	0	9	0	0	3	45.0	0	0.0	0.0	0.0	0.0	PROJECT NAME: STATEWIDE-SOUTH REGION PROJECT NUMBER: STPG SIGN(57)		
VERMONT AGENCY OF TRANSPORTATION							TOWN DIRECTIONAL TOTALS					489.4	0.0	46	4	4	100	0	0	86	1250.0	0		0.0			FILE NAME: z16t041Wallinaford140EB.xls PLOT DATE: 2/27/2017 PROJECT MANAGER: D. MUNRO DRAWN BY: W. GORDON DESIGNED BY: P. MCKECHNIE CHECKED: BRZEZOWSKA WALLINGFORD VT-140 EB 1 SHEET 197 OF 264		