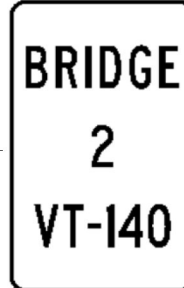


DIRECTION	MILEPOINT	LOCATION CODE (SHEET 4)	SIGN CODE	WIDTH (IN)	HEIGHT (IN)	SHEETING REMARKS	SIGN LEGEND	NEW SIGNS		EXISTING SIGNS				EXIST POST		NUMBER OF NEW POSTS	SQUARE STEEL (IN)			TUBULAR STEEL Ø (IN)				SIGN FRAME REQUIRED	REMARKS	SIGN DETAIL LOCATION			
								"A"	"B"	RETAIN	SALVAGE FROM	SALVAGE TO	REMOVE	RETAIN	REMOVE		1.75	2.00	2.50	FOUNDATION	3.00	3.50	4.00			5.00	SHSM	SIGN DETAILS SHEET #	STANDARD SHEET #
																	(LB / FT)				(LB / FT)								
																	1.88	2.42	3.35		7.60	9.00	10.80			14.60			
EB WALLINGFORD VT RTE 140							FY-FLUORESCENT YELLOW FYG-FLUORESCENT YELLOW GREEN															"SHSM"-STANDARD HIGHWAY SIGNS AND MARKINGS BOOK							
		A	W7-3aP				 11/9/17					1																	
		A	W1-5L	30	30		 11/20/17	6.25								1		14'-0" X								X			
		A	W7-3aP	24	18			3.00																	X				
EB	0.600	A	R2-1				 10/20/17					1	X																
		A	R2-1	24	30			5.00																	X				
EB	0.862	A	W1-4R	30	30		 10/20/17	6.25								1		14'-6" X								X			
EB	1.050	A	R2-1				 10/20/17					1	X																
		A	R2-1	24	30			5.00																	X				
EB	1.095	B	W1-6				 11/28/17					1		X															
		B	W1-6	48	24			8.00								2		14'-0" 13'-9" X							X				
EB	1.111	A	W1-6	48	24		 11/13/17	8.00								2		13'-3" 12'-6" X								X			
EB	1.310	A	VD-701				 11/9/17					1		X															
		A	VD-701	6	10			0.42								1		7'-6" X									T-42		
EB	1.345	A	W1-3L	30	30		 4/9/18	6.25								1		13'-6" X								X			
		A	W13-1P	18	18		 4/9/18	2.25																	X				
SIGN SUMMARY SHEET							SHEET TOTALS	50.42	0.00	0	0	0	5	0	0	8		115.0		0	0.0	0.0	0.0	0.0	PROJECT NAME: STATEWIDE-SOUTH REGION	PROJECT NUMBER: STPG SIGN(57)			
								SF	SF	EA	EA	EA	EA	EA	EA	EA		FT		EA	LB	LB	LB	LB	FILE NAME: z16t041Wallinaford140EB.xls	PLOT DATE: 2/27/2017			
																									PROJECT MANAGER: D. MUNRO	DRAWN BY: W. GORDON			
VERMONT AGENCY OF TRANSPORTATION							TOWN DIRECTIONAL TOTALS	489.4	0.0	46	4	4	100	0	0	86		1250.0		0	0.0			DESIGNED BY: P. MCKECHNIE	CHECKED: BRZEZOWSKI				
																							WALLINGFORD VT-140 EB 4	SHEET 200 OF 264					