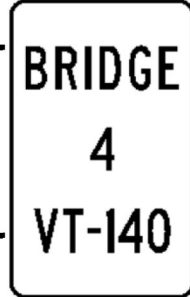


DIRECTION	MILEPOINT	LOCATION CODE (SHEET 4)	SIGN CODE	WIDTH (IN)	HEIGHT (IN)	SHEETING REMARKS	SIGN LEGEND	NEW SIGNS		EXISTING SIGNS				EXIST POST		NUMBER OF NEW POSTS	SQUARE STEEL (IN)			TUBULAR STEEL Ø (IN)				SIGN FRAME REQUIRED	REMARKS	SIGN DETAIL LOCATION			
								"A"	"B"	RETAIN	SALVAGE FROM	SALVAGE TO	REMOVE	RETAIN	REMOVE		1.75	2.00	2.50	FOUNDATION	3.00	3.50	4.00			5.00	SHSM	SIGN DETAILS SHEET #	STANDARD SHEET #
																	(LB / FT)				(LB / FT)								
																	1.88	2.42	3.35		7.60	9.00	10.80			14.60			
EB WALLINGFORD VT RTE 140							FY-FLUORESCENT YELLOW FYG-FLUORESCENT YELLOW GREEN															"SHSM"-STANDARD HIGHWAY SIGNS AND MARKINGS BOOK							
		A	W13-1P				 25 MPH					1																	
		A	W1-5R	30	30	FY		6.25								1		14'-3" X									X		
		A	W7-3aP	24	18	FY		3.00																		X			
EB	2.347	A	W1-4R																										
EB	2.375	A	VW-285	30	30	FY	 11/4/17	6.25					+		X	1		13'-0" X							INSTALL SIGN ±150' UPSTATION FROM EXISTING SIGN AT MP 2.347 EB			1	
EB	2.487	A	VD-701	6	10		 11/4/17	0.42								1		7'-3" X											T-42
EB	2.488	A	OM3-R																										
		A	VD-701																										
		A	OM3-R	12	36	FY	 4/9/18	3.00								1		9'-9" X									X		
EB	2.495	B	OM3-L	12	36	FY	 11/13/17	3.00								1		10'-9" X							INSTALL ON UPSTATION END OF BRIDGE		X		
EB	2.524	A	W1-3R	30	30	FY	 11/4/17	6.25								1		12'-3" X							INSTALL ±190' UPSTATION FROM BRIDGE PLAQUE AT MP 2.488 EB (ADJUST LOCATION UP TO 125' WEST IF LEDGE ENCOUNTERED)		X		
		A	W13-1P	18	18	FY		2.25																			X		
EB	2.556	B	W1-6R				 11/4/17																						
		B	W1-6R	48	24	FY		8.00																	INSTALL ON RETAINED POSTS		X		
SIGN SUMMARY SHEET							SHEET TOTALS	38.42	0.00	0	0	0	6	0	0	5		70.0		0	0.0	0.0	0.0	0.0	PROJECT NAME: STATEWIDE-SOUTH REGION	PROJECT NUMBER: STPG SIGN(57)			
								SF	SF	EA	EA	EA	EA	EA	EA	EA		FT		EA	LB	LB	LB	LB					
							VERMONT AGENCY OF TRANSPORTATION	TOWN DIRECTIONAL TOTALS	489.4	0.0	46	4	4	100	0	0	86		1250.0		0		0.0					FILE NAME: z16t041Wallinaford140EB.xls	PLOT DATE: 2/27/2017
																						PROJECT MANAGER: D. MUNRO	DRAWN BY: W. GORDON			CHECKED: BRZEZOWSKI			
																						DESIGNED BY: P. MCKECHNIE	SHEET 203 OF 264						
																							WALLINGFORD VT-140 EB 7						