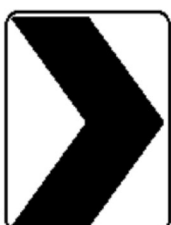
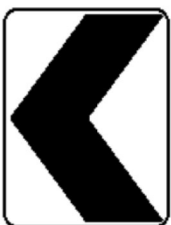


DIRECTION	MILEPOINT	LOCATION CODE (SHEET 4)	SIGN CODE	WIDTH (IN)	HEIGHT (IN)	SHEETING REMARKS	SIGN LEGEND	NEW SIGNS		EXISTING SIGNS				EXIST POST		NUMBER OF NEW POSTS	SQUARE STEEL (IN)			TUBULAR STEEL Ø (IN)				SIGN FRAME REQUIRED	REMARKS	SIGN DETAIL LOCATION			
								"A"	"B"	RETAIN	SALVAGE FROM	SALVAGE TO	REMOVE	RETAIN	REMOVE		1.75	2.00	2.50	FOUNDATION	3.00	3.50	4.00			5.00	SHSM	SIGN DETAILS SHEET #	STANDARD SHEET #
																	(LB / FT)				(LB / FT)								
																	1.88	2.42	3.35		7.60	9.00	10.80			14.60			
EB WALLINGFORD VT RTE 140							FY-FLUORESCENT YELLOW FYG-FLUORESCENT YELLOW GREEN															"SHSM"-STANDARD HIGHWAY SIGNS AND MARKINGS BOOK							
EB	3.790	A	W1-8L	18	24	FY	 11/4/17	3.00							1		12'-0" X							INSTALL 160' UPSTATION FROM EXISTING RIGHT CHEVRON AT MP 3.760 EB	X				
EB	3.791	B	W1-8R	18	24	FY	 11/4/17	3.00							1		12'-0" X							INSTALL 160' UPSTATION FROM EXISTING RIGHT CHEVRON AT MP 3.760 EB	X				
EB	3.800	A	W1-8L				CHEVRON						1		X														
EB	3.801	B	W1-8R				CHEVRON						1		X														
EB	3.805	A	W1-8L	18	24	FY	 11/4/17	3.00							1		12'-0" X							INSTALL 240' UPSTATION FROM EXISTING RIGHT CHEVRON AT MP 3.760 EB	X				
EB	3.806	B	W1-8R	18	24	FY	 11/4/17	3.00							1		12'-0" X							INSTALL 240' UPSTATION FROM EXISTING RIGHT CHEVRON AT MP 3.760 EB	X				
EB	3.820	A	W1-8L				CHEVRON						1		X														
		B	W1-8R				CHEVRON						1																
EB	3.820	A	W1-8L	18	24	FY	 11/4/17	3.00							1		11'-3" X							INSTALL 320' UPSTATION FROM EXISTING RIGHT CHEVRON AT MP 3.760 EB	X				
EB	3.821	B	W1-8R	18	24	FY	 11/4/17	3.00							1		12'-0" X							INSTALL 320' UPSTATION FROM EXISTING RIGHT CHEVRON AT MP 3.760 EB	X				
EB	3.835	A	W1-8L	18	24	FY	 11/6/17	3.00							1		12'-0" X							INSTALL 400' UPSTATION FROM EXISTING RIGHT CHEVRON AT MP 3.760 EB	X				
EB	4.265	A	W2-2L				T-INTERSECTION SIDE ROAD						1		X														
EB	4.350	A	R2-1				SPEED LIMIT 50						1	X															
		A	R2-1	24	30		 11/7/17	5.00																INSTALL ON RETAINED POST	X				
EB	4.715	A	W2-1				CROSS ROAD						1		X														
SIGN SUMMARY SHEET							SHEET TOTALS	26.00	0.00	0	0	0	7	0	0	7		105.0		0	0.0	0.0	0.0	0.0	PROJECT NAME: STATEWIDE-SOUTH REGION	PROJECT NUMBER: STPG SIGN(57)			
								SF	SF	EA	EA	EA	EA	EA	EA	EA		FT		EA	LB	LB	LB	LB					
							VERMONT AGENCY OF TRANSPORTATION	TOWN DIRECTIONAL TOTALS	489.4	0.0	46	4	4	100	0	0	86		1250.0		0		0.0						FILE NAME: z16t041Wallinaford140EB.xls
																					DESIGNED BY: P. MCKECHNIE	CHECKED: BRZEZOWSKI	SHEET 206 OF 264						