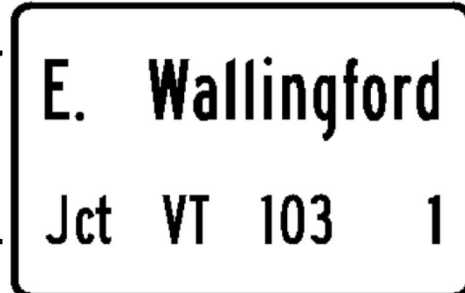
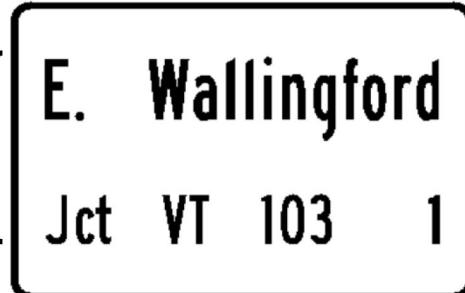
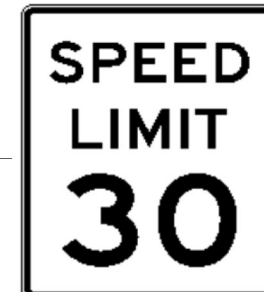
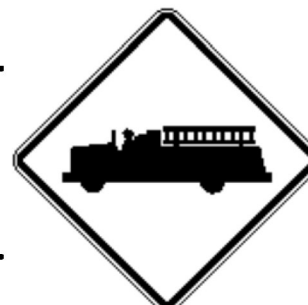
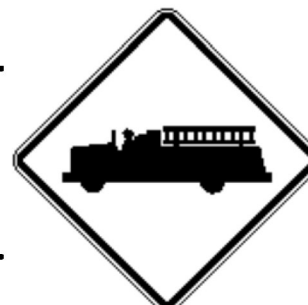


DIRECTION	MILEPOINT	LOCATION CODE (SHEET 4)	SIGN CODE	WIDTH (IN)	HEIGHT (IN)	SHEETING REMARKS	SIGN LEGEND	NEW SIGNS		EXISTING SIGNS				EXIST POST		NUMBER OF NEW POSTS	SQUARE STEEL (IN)			TUBULAR STEEL Ø (IN)				SIGN FRAME REQUIRED	REMARKS	SIGN DETAIL LOCATION								
								"A"	"B"	RETAIN	SALVAGE FROM	SALVAGE TO	REMOVE	RETAIN	REMOVE		1.75	2.00	2.50	FOUNDATION	3.00	3.50	4.00			5.00	SHSM	SIGN DETAILS SHEET #	STANDARD SHEET #					
																	(LB / FT)				(LB / FT)													
																	1.88	2.42	3.35		7.60	9.00	10.80			14.60								
EB WALLINGFORD VT RTE 140							FY-FLUORESCENT YELLOW FYG-FLUORESCENT YELLOW GREEN															"SHSM"-STANDARD HIGHWAY SIGNS AND MARKINGS BOOK												
EB	5.555	A	W2-3R	30	30			11/2/17	6.25							1	15'-3" X							INSTALL SIGN ±260' UPSTATION FROM EXISTING SIGN AT MP 5.505 EB	X									
		A	W16-8aP	24	8				1.33																5									
EB	5.610	A	W1-5R	30	30			4/9/17	6.25							1	12'-3" X							INSTALL SIGN ±90' UPSTATION FROM CENTERLINE OF PARKER RD (TH-24)	X									
		A	W13-1P	18	18				2.25																X									
EB	5.790	A	W3-5					11/1/17					1		X																			
		A	W3-5	36	36			11/1/17	9.00							2	12'-0" 11'-9" X								X									
EB	5.835	A	VD-018A	36	24				6.00							1	12'-3" X										T-95							
EB	5.890	A	R2-1					11/21/17					1		X																			
		A	R2-1	30	36			11/2/17	7.50							1	14'-3" X								X									
EB	5.911	A	W11-8	30	30				6.25							1	12'-9" X							INSTALL SIGN ±100' DOWNSTATION FROM EXISTING SIGN AT MP 5.930 EB	X									
EB	5.930	A	W11-8				EMERGENCY VEHICLE						1		X																			
EB	5.961	A	W1-1L				LEFT TURN						1		X																			
		A	W13-1P				20 MPH						1																					
EB	6.000	A	W10-1					11/1/17					1		X																			
		A	W10-1	36	36				7.07															INSTALL ON RETAINED POST 36" DIAMETER	X									
SIGN SUMMARY SHEET							SHEET TOTALS	51.90	0.00	0	0	0	6	0	0	7	105.0	0	0.0	0.0	0.0	0.0	PROJECT NAME: STATEWIDE-SOUTH REGION	PROJECT NUMBER: STPG SIGN(57)										
								SF	SF	EA	EA	EA	EA	EA	EA	EA		FT		EA	LB	LB	LB				LB							
							VERMONT AGENCY OF TRANSPORTATION							TOWN DIRECTIONAL TOTALS	489.4	0.0	46	4	4	100	0	0	86	1250.0	0	0.0				FILE NAME: z16t041Wallinaford140EB.xls	PLOT DATE: 2/27/2017			
																																PROJECT MANAGER: D. MUNRO	DRAWN BY: W. GORDON	
																					DESIGNED BY: P. MCKECHNIE	CHECKED: BRZEZOWSKI												
																						WALLINGFORD VT-140 EB 12				SHEET 208 OF 264								