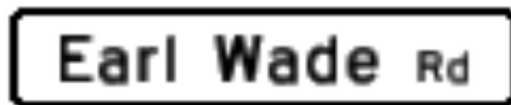


DIRECTION	MILEPOINT	LOCATION CODE (SHEET 4)	SIGN CODE	WIDTH (IN)	HEIGHT (IN)	SHEETING REMARKS	SIGN LEGEND	NEW SIGNS		EXISTING SIGNS				EXIST POST		NUMBER OF NEW POSTS	SQUARE STEEL (IN)			TUBULAR STEEL Ø (IN)				SIGN FRAME REQUIRED	REMARKS	SIGN DETAIL LOCATION							
								"A"	"B"	RETAIN	SALVAGE FROM	SALVAGE TO	REMOVE	RETAIN	REMOVE		1.75	2.00	2.50	FOUNDATION	3.00	3.50	4.00			5.00	SHSM	SIGN DETAILS SHEET #	STANDARD SHEET #				
																	(LB / FT)				(LB / FT)												
																	1.88	2.42	3.35		7.60	9.00	10.80			14.60							
EB WALLINGFORD VT RTE 140							FY-FLUORESCENT YELLOW FYG-FLUORESCENT YELLOW GREEN															"SHSM"-STANDARD HIGHWAY SIGNS AND MARKINGS BOOK											
		C	M3-3				SOUTH			1																							
		C	VM5-1				VERMONT 155			1																							
		C	M6-1L				LEFT ARROW			1																							
		C	M3-4				WEST			1																							
		C	VM5-1				VERMONT 140			1																							
		C	M6-1R				RIGHT ARROW			1																							
EB	6.180	C	VR-017				 11/2/17						1	X																			
		C	VR-017	24	30			5.00																	INSTALL ON RETAINED POST				T-70				
EB	6.186	D	R1-1				 11/2/17						1		X																		
		D	R1-1	30	30			6.25									1	13'-3" X								X							
EB	6.187	AB	D3-1	56	12		 11/2/17	4.67								2	11'-0" 10'-3" X								INSTALL SIGN ±10' UPSTATION FROM STOP SIGN AT MP 6.186 EB		9						
EB	6.200	A	VD1-1A				(UP) Mount Holly 2			1				X																			
		A	VD1-1A				(UP) Ludlow 11			1																							
		A	VD1-1A				Weston 14 -->			1																							
		A	VD1-1A				Londonderry 19 -->			1																							
SIGN SUMMARY SHEET							SHEET TOTALS	15.92	0.00	10	0	0	2	0	0	3		45.0		0	0.0	0.0	0.0	0.0	PROJECT NAME: STATEWIDE-SOUTH REGION	PROJECT NUMBER: STPG SIGN(57)							
								SF	SF	EA	EA	EA	EA	EA	EA	EA		FT		EA	LB	LB	LB	LB									
							VERMONT AGENCY OF TRANSPORTATION							TOWN DIRECTIONAL TOTALS	489.4	0.0	46	4	4	100	0	0	86		1250.0		0	0.0				FILE NAME: z16t041Wallinaford140EB.xls	PLOT DATE: 2/27/2017
																							DESIGNED BY: P. MCKECHNIE	CHECKED: BRZEZOWSKI									
																								WALLINGFORD VT-140 EB 16	SHEET 212 OF 264								