

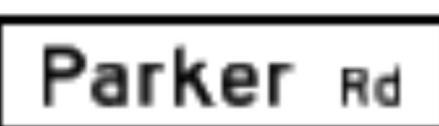
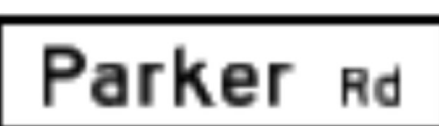





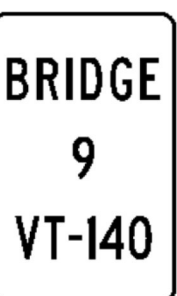
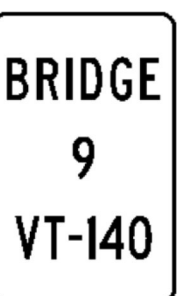


DIRECTION	MILEPOINT	LOCATION CODE (SHEET 4)	SIGN CODE	WIDTH (IN)	HEIGHT (IN)	SHEETING REMARKS	SIGN LEGEND	NEW SIGNS		EXISTING SIGNS			EXIST POST		NUMBER OF NEW POSTS	SQUARE STEEL (IN)			TUBULAR STEEL Ø (IN)				SIGN FRAME REQUIRED	REMARKS	SIGN DETAIL LOCATION				
								"A"	"B"	RETAIN	SALVAGE FROM	SALVAGE TO	REMOVE	RETAIN		REMOVE	1.75	2.00	2.50	FOUNDATION	3.00	3.50			4.00	5.00	SHSM	SIGN DETAILS SHEET #	STANDARD SHEET #
																	(LB / FT)				(LB / FT)								
WB WALLINGFORD VT RTE 140							FY-FLUORESCENT YELLOW FYG-FLUORESCENT YELLOW GREEN															"SHSM"-STANDARD HIGHWAY SIGNS AND MARKINGS BOOK							
		F	W2-3R	30	30			10/31/17	6.25														INSTALL ON RETAINED POST	X					
		F	W16-8aP	24	8				1.33																5				
WB	5.595	FE						10/31/17															PARKER RD (TH-24)						
		FE	D3-1	42	12			10/31/17	3.50						1		10'-6"	X							9				
WB	5.595	G	VR-017					10/31/17																					
		G	VR-017	24	30				5.00													INSTALL ON RETAINED POST			T-70				
WB	5.590	H	R1-1					10/31/17															STOP						
		H	R1-1	30	30				6.25													THINNING AND TRIMMING INSTALL ON RETAINED POST	X						
WB	5.280	F	W2-2R																				SIDE ROAD						
		F	W1-10L	36	36			11/20/17	9.00															X					
		F	W16-8aP	33	8				1.83																5				
WB	5.200	F	VD-701					10/31/17																					
		F	VD-701	6	10			10/31/17	0.42						1		7'-3"	X								T-42			
WB	5.171	FE																				HATEFUL HILL RD							
		G	VR-017																			LLL 24,000 LBS							
SIGN SUMMARY SHEET							SHEET TOTALS		33.17	0.00	0	0	0	7	0	0	4	55.0	0	0.0	0.0	0.0	0.0	PROJECT NAME: STATEWIDE-SOUTH REGION					
							SF	SF	EA	EA	EA	EA	EA	EA	EA	EA	EA	FT	EA	LB	LB	LB	LB	PROJECT NUMBER: STPG SIGN(57)					
VERMONT AGENCY OF TRANSPORTATION							TOWN DIRECTIONAL TOTALS		572.0	0.0	35	2	2	128	0	0	93	1325.0	2		183.0			FILE NAME: z16t041Wallinaford140WB.xls	PLOT DATE: 2/27/2017				
																							PROJECT MANAGER: D. MUNRO	DRAWN BY: W. GORDON					
																							DESIGNED BY: P. MCKECHNIE	CHECKED: BRZEZOWSK					
																							WALLINGFORD VT-140 WB 5	SHEET 219 OF 264					