




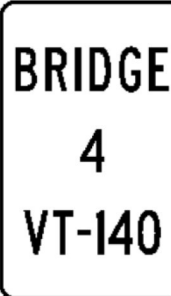





DIRECTION	MILEPOINT	LOCATION CODE (SHEET 4)	SIGN CODE	WIDTH (IN)	HEIGHT (IN)	SHEETING REMARKS	SIGN LEGEND	NEW SIGNS		EXISTING SIGNS			EXIST POST		NUMBER OF NEW POSTS	SQUARE STEEL (IN)			TUBULAR STEEL Ø (IN)				SIGN FRAME REQUIRED	REMARKS	SIGN DETAIL LOCATION				
								"A"	"B"	RETAIN	SALVAGE FROM	SALVAGE TO	REMOVE	RETAIN		REMOVE	1.75	2.00	2.50	FOUNDATION	3.00	3.50			4.00	5.00	SHSM	SIGN DETAILS SHEET #	STANDARD SHEET #
																	(LB / FT)				(LB / FT)								
WB WALLINGFORD VT RTE 140							FY-FLUORESCENT YELLOW FYG-FLUORESCENT YELLOW GREEN															"SHSM"-STANDARD HIGHWAY SIGNS AND MARKINGS BOOK							
		G					HIKING TRAIL (PLAQUE)			1																			
WB	2.622	F					WATCH FOR FALLEN ROCK					1																	
		F	VW-285	30	30	FY		11/7/17															1						
WB	2.580	F	W1-3R	30	30	FY		11/7/17																					
		F	W13-1P	18	18	FY																							
WB	2.538	F	W1-6L				ONE DIRECTION LARGE ARROW LEFT					1																	
		E	W1-6R				ONE DIRECTION LARGE ARROW RIGHT					1																	
		F	W1-6	48	24	FY		11/21/17															X						
WB	2.536	E	W1-6	48	24	FY		11/21/17															X						
WB	2.491	F	VD-701	6	10			11/7/17																					
WB	2.490	F	OM3-R				RIGHT OBJECT MARKER					1																	
		F	VD-701				BRIDGE 4 PLAQUE					1																	
		F	OM3-R	12	36	FY		11/27/17															X						
WB	2.480	E	OM3-L	12	36	FY		11/13/17															X						
WB	2.446	E	W1-6	48	24	FY		11/21/17															X						
SIGN SUMMARY SHEET							SHEET TOTALS		45.17	0.00	1	0	0	5	0	0	11	160.0	0	0.0	0.0	0.0	0.0	PROJECT NAME: STATEWIDE-SOUTH REGION PROJECT NUMBER: STPG SIGN(57)					
							SF	SF	EA	EA	EA	EA	EA	EA	EA	EA	EA	FT	EA	LB	LB	LB	LB	FILE NAME: z16t041Wallinaford140WB.xls PLOT DATE: 2/27/2017 PROJECT MANAGER: D. MUNRO DRAWN BY: W. GORDON DESIGNED BY: P. MCKECHNIE CHECKED: BRZEZOWSKA WALLINGFORD VT-140 WB 11 SHEET 225 OF 264					
VERMONT AGENCY OF TRANSPORTATION							TOWN DIRECTIONAL TOTALS		572.0	0.0	35	2	2	128	0	0	93	1325.0	2		183.0								