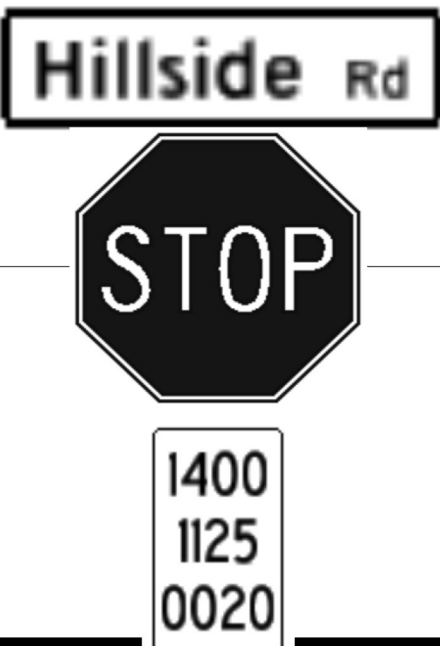


DIRECTION	MILEPOINT	LOCATION CODE (SHEET 4)	SIGN CODE	WIDTH (IN)	HEIGHT (IN)	SHEETING REMARKS	SIGN LEGEND	NEW SIGNS		EXISTING SIGNS				EXIST POST		NUMBER OF NEW POSTS	SQUARE STEEL (IN)			TUBULAR STEEL Ø (IN)				SIGN FRAME REQUIRED	REMARKS	SIGN DETAIL LOCATION			
								"A"	"B"	RETAIN	SALVAGE FROM	SALVAGE TO	REMOVE	RETAIN	REMOVE		1.75	2.00	2.50	FOUNDATION	3.00	3.50	4.00			5.00	SHSM	SIGN DETAILS SHEET #	STANDARD SHEET #
																	(LB / FT)				(LB / FT)								
																	1.88	2.42	3.35		7.60	9.00	10.80			14.60			
WB WALLINGFORD VT RTE 140							FY-FLUORESCENT YELLOW FYG-FLUORESCENT YELLOW GREEN															"SHSM"-STANDARD HIGHWAY SIGNS AND MARKINGS BOOK							
		F	W16-2				 400 FEET PLAQUE					1																	
		F	S1-1	30	30	FYG		6.25						1		11'-9" X										X			
		F	W16-2P	24	18	FYG		3.00																		X			
WB	0.232	F	R2-1				 11/13/17					1		X															
		F	R2-1	24	30			5.00						1		13'-0" X										X			
WB	0.210	G	VR-017				 11/8/17						1		X														
		G	W14-2										1																
		G	VR-017	24	30			5.00						1		12'-0" X												T-70	
WB	0.210	G	W14-2	24	24		 11/20/17	4.00								1		12'-9" X							INSTALL NO OUTLET SIGN ±50' BEYOND LLL 24,000. STICKER ON BACK OF SIGN SHALL READ "WALLINGFORD"	X			
WB	0.205	H	R1-1				 11/8/17						1		X														
		G	VD-700											1															
WB	0.205	FE	D3-1											1		X													
WB	0.205	FE	D3-1	42	12			3.50								1		13'-0" X							INSTALL POST SIDE BY SIDE WITH SCHOOL WARNING SIGN INSTALL TH SIGN ON TOP OF STOP SIGN		9		
		H	R1-1	30	30			6.25																	X				
		G	VD-700	6	10			0.42																	INSTALL BACK TO BACK ON STOP SIGN POST			T-44	
SIGN SUMMARY SHEET							SHEET TOTALS		33.42	0.00	0	0	0	7	0	0	5	75.0			0	0.0	0.0	0.0	0.0	PROJECT NAME: STATEWIDE-SOUTH REGION			
									SF	SF	EA	EA	EA	EA	EA	EA	EA	FT			EA	LB	LB	LB	LB	PROJECT NUMBER: STPG SIGN(57)			
																									FILE NAME: z16t041Wallinaford140WB.xls			PLOT DATE: 2/27/2017	
VERMONT AGENCY OF TRANSPORTATION							TOWN DIRECTIONAL TOTALS		572.0	0.0	35	2	2	128	0	0	93	1325.0			2	183.0				PROJECT MANAGER: D. MUNRO			DRAWN BY: W. GORDON
																									DESIGNED BY: P. MCKECHNIE			CHECKED: BRZEZOWSKI	
																									WALLINGFORD VT-140 WB 15			SHEET 229 OF 264	