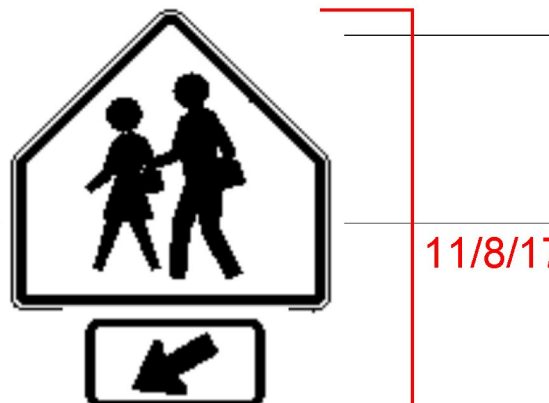
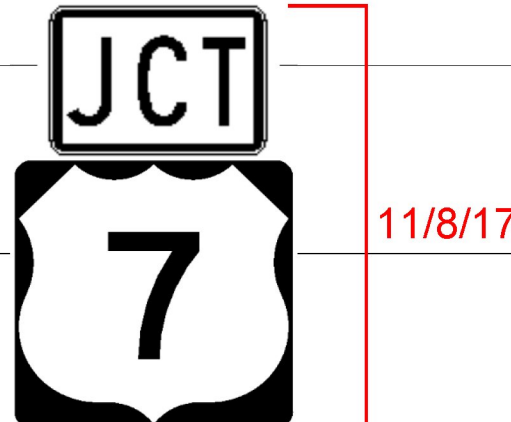
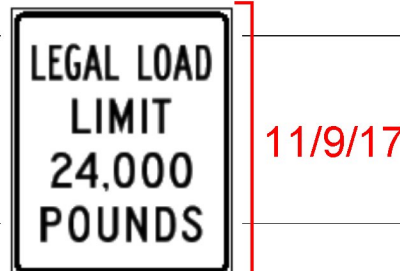
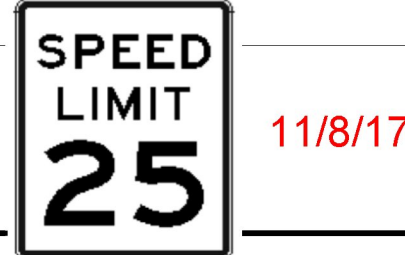


DIRECTION	MILEPOINT	LOCATION CODE (SHEET 4)	SIGN CODE	WIDTH (IN)	HEIGHT (IN)	SHEETING REMARKS	SIGN LEGEND	NEW SIGNS		EXISTING SIGNS				EXIST POST		NUMBER OF NEW POSTS	SQUARE STEEL (IN)			TUBULAR STEEL Ø (IN)				SIGN FRAME REQUIRED	REMARKS	SIGN DETAIL LOCATION					
								"A"	"B"	RETAIN	SALVAGE FROM	SALVAGE TO	REMOVE	RETAIN	REMOVE		1.75	2.00	2.50	FOUNDATION	3.00	3.50	4.00			5.00	SHSM	SIGN DETAILS SHEET #	STANDARD SHEET #		
																	(LB / FT)				(LB / FT)										
																	1.88	2.42	3.35		7.60	9.00	10.80			14.60					
WB WALLINGFORD VT RTE 140							FY-FLUORESCENT YELLOW FYG-FLUORESCENT YELLOW GREEN															"SHSM"-STANDARD HIGHWAY SIGNS AND MARKINGS BOOK									
WB	0.205	F	W11-2									1		X																	
		F	W16-7p										1																		
		F	W11-2	30	30	FYG		6.25								1			13'-9" X							PROVIDE 7' CLEAR HEIGHT	X				
		F	W16-7p	24	12	FYG		2.00																			X				
WB	0.165	F	M2-1									1	X																		
		F	M1-4										1																		
		F	M2-1	21	15			2.19																		INSTALL ON RETAINED POST	X				
		F	M1-4	24	24			4.00																			X				
WB	0.144	G	VR-017				 	LLL 24,000 LBS					1	X														PROSPECT ST (TH-10)			
		G				NO THRU TRUCKS					1																				
		G	R2-1			SPEED LIMIT 25					1																				
		G	VR-017	24	30			5.00																		INSTALL ON RETAINED POST			T-70		
		G	R2-1	18	24			3.00																		STICKER ON BACK OF SIGN SHALL READ "WALLINGFORD", NOT "VAOT"	X				
WB	0.138	H	R1-1				STOP						X																		
		G	VD-700				MILE MARKER 1400/1125/0014						1																		
SIGN SUMMARY SHEET							SHEET TOTALS		22.44	0.00	0	0	0	9	0	0	1	15.0			0	0.0	0.0	0.0	0.0	PROJECT NAME: STATEWIDE-SOUTH REGION					
									SF	SF	EA	EA	EA	EA	EA	EA	EA	FT			EA	LB	LB	LB	LB	PROJECT NUMBER: STPG SIGN(57)					
																									FILE NAME: z16t041Wallinaford140WB.xls						
																									PLOT DATE: 2/27/2017						
VERMONT AGENCY OF TRANSPORTATION							TOWN DIRECTIONAL TOTALS		572.0	0.0	35	2	2	128	0	0	93	1325.0			2	183.0				DRAWN BY: W. GORDON					
																									CHECKED: BRZEZOWSKI						
																									DESIGNED BY: P. MCKECHNIE						
																						WALLINGFORD VT-140 WB 16			SHEET 230 OF 264						