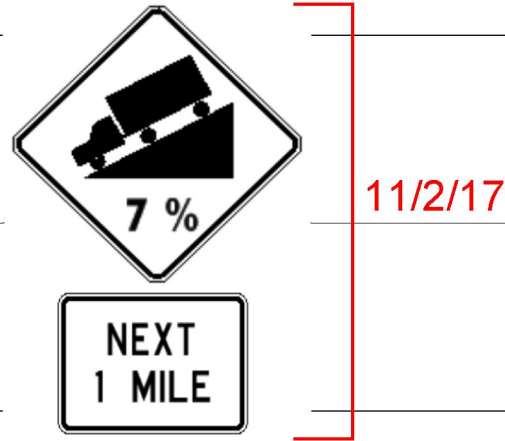
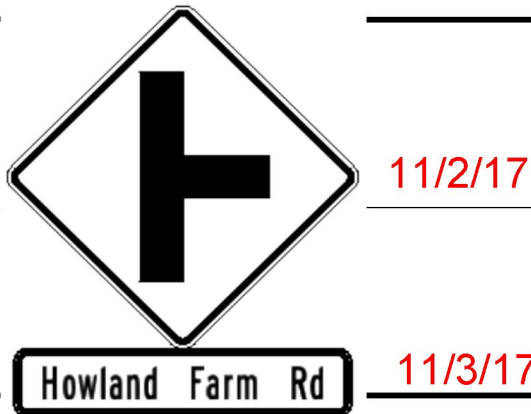
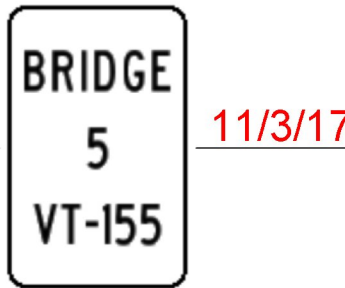


DIRECTION	MILEPOINT	LOCATION CODE (SHEET 4)	SIGN CODE	WIDTH (IN)	HEIGHT (IN)	SHEETING REMARKS	SIGN LEGEND	NEW SIGNS		EXISTING SIGNS				EXIST POST		NUMBER OF NEW POSTS	SQUARE STEEL (IN)			TUBULAR STEEL Ø (IN)				SIGN FRAME REQUIRED	REMARKS	SIGN DETAIL LOCATION				
								"A"	"B"	RETAIN	SALVAGE FROM	SALVAGE TO	REMOVE	RETAIN	REMOVE		1.75	2.00	2.50	FOUNDATION	3.00	3.50	4.00			5.00	SHSM	SIGN DETAILS SHEET #	STANDARD SHEET #	
																	(LB / FT)				(LB / FT)									
																	1.88	2.42	3.35		7.60	9.00	10.80			14.60				
NB MT HOLLY VT 155							FY-FLUORESCENT YELLOW FYG-FLUORESCENT YELLOW GREEN															"SHSM"-STANDARD HIGHWAY SIGNS AND MARKINGS BOOK								
NB	1.000	A	W7-1a																											
		A	W7-3aP																											
		A	W7-1a	30	30			6.25											15'-3" X						X					
		A	W7-3aP	24	18			3.00																	X					
NB	1.915	A	VW-054L																											
		A	VW-054L	30	30			6.25											15'-6" X							T-80				
NB	2.078	A	W2-2	30	30			6.25																						
		A	W16-8P	39	8			2.17											15'-0" X						X					
							Howland Farm Rd	11/3/17																	4					
NB	2.115	A	VD-701																											
		A	VD-701	6	10			0.42											9'-0" X							T-42				
NB	2.125	C	VR-017																											
		C	VR-017	24	30			5.00											14'-3" X							T-70				
NB	2.133	D	R1-1																											
		C	VD-700																											
		D	R1-1	30	30			6.25											13'-6" X						X					
SIGN SUMMARY SHEET							SHEET TOTALS	35.58	0.00	0	1	0	7	0	0	6	85.0	0	0.0	0.0	0.0	0.0	PROJECT NAME: STATEWIDE-SOUTH REGION							
								SF	SF	EA	EA	EA	EA	EA	EA	EA		FT	EA	LB	LB	LB	LB	PROJECT NUMBER: STPG SIGN(57)						
																					FILE NAME: z16t041Mt HollyVT155 NB.xls							PLOT DATE: 2/27/2017		
																					PROJECT MANAGER: D. MUNRO							DRAWN BY: W. GORDON		
VERMONT AGENCY OF TRANSPORTATION							TOWN DIRECTIONAL TOTALS	235.3	0.0	10	4	4	56	0	1	50	675.0	0	0.0				DESIGNED BY: P. MCKECHNIE			CHECKED BRZEZOWSKI				
																					MOUNT HOLLY VT-155 NB 2							SHEET 243 OF 264		