



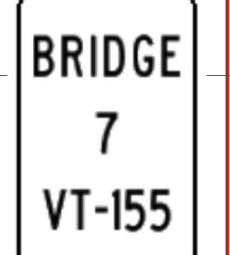
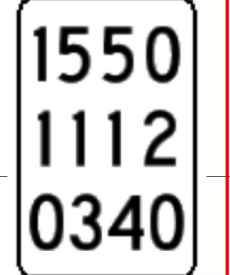


DIRECTION	MILEPOINT	LOCATION CODE (SHEET 4)	SIGN CODE	WIDTH (IN)	HEIGHT (IN)	SHEETING REMARKS	SIGN LEGEND	NEW SIGNS		EXISTING SIGNS			EXIST POST		NUMBER OF NEW POSTS	SQUARE STEEL (IN)			TUBULAR STEEL Ø (IN)				SIGN FRAME REQUIRED	REMARKS	SIGN DETAIL LOCATION				
								"A"	"B"	RETAIN	SALVAGE FROM	SALVAGE TO	REMOVE	RETAIN		REMOVE	1.75	2.00	2.50	FOUNDATION	3.00	3.50			4.00	5.00	SHSM	SIGN DETAILS SHEET #	STANDARD SHEET #
																	(LB / FT)				(LB / FT)								
<b>NB MT HOLLY VT 155</b>							FY-FLUORESCENT YELLOW FYG-FLUORESCENT YELLOW GREEN															"SHSM"-STANDARD HIGHWAY SIGNS AND MARKINGS BOOK							
NB	2.975	C	VR-017				 11/2/17					1	X									MAPLE HILL RD (TH-22)							
		C	VR-017	24	30																	INSTALL SIGN ON RETAINED POST AT SAME STATION			T-70				
NB	2.981	AB	D3-1				 11/2/17					1		X															
		AB	D3-1	72	12										2							INSTALL INDEPENDENTLY ON TWO POSTS 10' FROM EDGE OF PAVEMENT		10					
NB	2.981	D	R1-1				 11/2/17					1		X															
		C	VD-700									1																	
		D	R1-1	30	30										1														
		C	VD-700	6	10																	INSTALL BACK TO BACK ON STOP SIGN POST			T-44				
NB	3.210	A	W11-7				 11/6/17					1		X															
		A	W11-7	30	30										1														
NB	3.400	AB	D3-1				SPRUCE LN PVT		1					X															
NB	3.410	A	VD-701				 11/6/17					1		X															
		A	VD-700									1																	
		A	VD-701	6	10										1										T-42				
		A	VD-700	6	10																				T-44				
<b>SIGN SUMMARY SHEET</b>							<b>SHEET TOTALS</b>	24.75	0.00	1	0	0	7	0	0	5	70.0	0	0.0	0.0	0.0	0.0	PROJECT NAME: STATEWIDE-SOUTH REGION PROJECT NUMBER: STPG SIGN(57)						
VERMONT AGENCY OF TRANSPORTATION							<b>TOWN DIRECTIONAL TOTALS</b>	235.3	0.0	10	4	4	56	0	1	50	675.0	0		0.0			FILE NAME: z16t041Mt HollivVT155 NB.xls PROJECT MANAGER: D. MUNRO DESIGNED BY: P. MCKECHNIE MOUNT HOLLY VT-155 NB 4	PLOT DATE: 2/27/2017 DRAWN BY: W. GORDON CHECKED: BRZEZOWSK SHEET 245 OF 264					