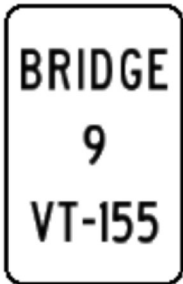


DIRECTION	MILEPOINT	LOCATION CODE (SHEET 4)	SIGN CODE	WIDTH (IN)	HEIGHT (IN)	SHEETING REMARKS	SIGN LEGEND	NEW SIGNS		EXISTING SIGNS				EXIST POST		NUMBER OF NEW POSTS	SQUARE STEEL (IN)			TUBULAR STEEL Ø (IN)				SIGN FRAME REQUIRED	REMARKS	SIGN DETAIL LOCATION					
								"A"	"B"	RETAIN	SALVAGE FROM	SALVAGE TO	REMOVE	RETAIN	REMOVE		1.75	2.00	2.50	FOUNDATION	3.00	3.50	4.00			5.00	SHSM	SIGN DETAILS SHEET #	STANDARD SHEET #		
																	(LB / FT)				(LB / FT)										
																	1.88	2.42	3.35		7.60	9.00	10.80			14.60					
NB MT HOLLY VT 155							FY-FLUORESCENT YELLOW FYG-FLUORESCENT YELLOW GREEN															"SHSM"-STANDARD HIGHWAY SIGNS AND MARKINGS BOOK									
NB	4.267	D	R1-1				 11/2/17						1		X																
		C	VD-700								1		1																		
		D	R1-1	30	30			6.25									1	14'-0" X							X						
		C	VD-700										1											INSTALL BACK TO BACK ON STOP SIGN POST							
NB	4.267	AB	D3-1				 11/2/17						1		X																
		AB	D3-1	72	12			6.00									2	11'-9" 11'-0" X						INSTALL 10' FROM STOP SIGN BETWEEN ROAD AND STOP SIGN		10					
NB	4.274	A											1		X																
		A	VM1-5											1																	
NB	4.290	A	M3-1	24	12		 11/7/17	2.00								1	14'-0" X							NORTH, GREEN ON WHITE	X						
		A	VM1-5	30	24			5.00																INSTALL 85' UPSTATION FROM EXISTING SIGN AT MP 4.274 NB			E-136				
NB	4.380	A	S3-1				 11/7/17						1		X																
		A	S3-1	36	36	FYG		9.00									2	14'-3" 14'-0" X							X						
NB	4.507	A	VD-701				 11/7/17						1		X																
		A	VD-701	6	10			0.42									1	8'-0" X									T-42				
NB	4.535	A	R2-1				SPEED LIMIT 50						1		X																
SIGN SUMMARY SHEET							SHEET TOTALS	28.67	0.00	0	1	1	8	0	0	7		100.0		0	0.0	0.0	0.0	0.0	PROJECT NAME: STATEWIDE-SOUTH REGION	PROJECT NUMBER: STPG SIGN(57)					
								SF	SF	EA	EA	EA	EA	EA	EA	EA		FT		EA	LB	LB	LB	LB							
							VERMONT AGENCY OF TRANSPORTATION																					FILE NAME: z16t041Mt HollivVT155 NB.xls	PLOT DATE: 2/27/2017		
														TOWN DIRECTIONAL TOTALS	235.3	0.0	10	4	4	56	0	1	50		675.0		0		0.0		
																						DESIGNED BY: P. MCKECHNIE	CHECKED: BRZEZOWSKI								
																							MOUNT HOLLY VT-155 NB 6	SHEET 247 OF 264							