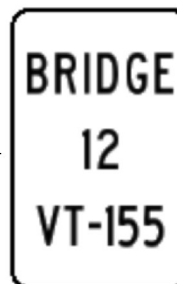
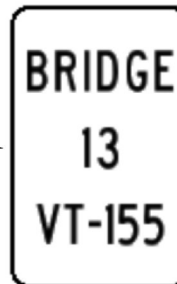
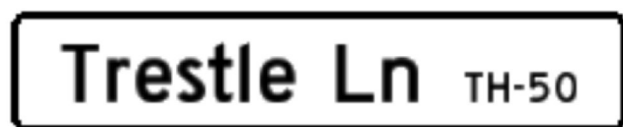


DIRECTION	MILEPOINT	LOCATION CODE (SHEET 4)	SIGN CODE	WIDTH (IN)	HEIGHT (IN)	SHEETING REMARKS	SIGN LEGEND	NEW SIGNS		EXISTING SIGNS				EXIST POST		NUMBER OF NEW POSTS	SQUARE STEEL (IN)			TUBULAR STEEL Ø (IN)				SIGN FRAME REQUIRED	REMARKS	SIGN DETAIL LOCATION					
								"A"	"B"	RETAIN	SALVAGE FROM	SALVAGE TO	REMOVE	RETAIN	REMOVE		1.75	2.00	2.50	FOUNDATION	3.00	3.50	4.00			5.00	SHSM	SIGN DETAILS SHEET #	STANDARD SHEET #		
																	(LB / FT)				(LB / FT)										
																	1.88	2.42	3.35		7.60	9.00	10.80			14.60					
NB MT HOLLY VT 155							FY-FLUORESCENT YELLOW FYG-FLUORESCENT YELLOW GREEN															"SHSM"-STANDARD HIGHWAY SIGNS AND MARKINGS BOOK									
NB	5.800	A	S3-1				 11/9/17 MILE MARKER 1550/1112/0580					1			X																
		A	VD-700								1		1																		
		A	S3-1	36	36	FYG		9.00								2		10'-6" 9'-3" X								X					
		A	VD-700										1												SALVAGE MILE MARKER ON LEFT POST OF NEW SIGN POST AT SAME STATION						
NB	6.440	A	W1-2L	30	30		 11/17/17 40 MPH	6.25								1		13'-0" X								INSTALL 140' UPSTATION FROM UTILITY POLE VTEL/23 AT MP 6.413	X				
		A	W13-1P	18	18			2.25																		X					
NB	6.880	A	VD-701				 11/13/17						1			X															
		A	VD-701	6	10			0.42								1		7'-6" X										T-42			
NB	7.110	A	VD-701				 11/13/17						1			X															
		A	VD-701	6	10			0.42								1		9'-0" X										T-42			
NB	7.210	A	W3-5				SPEED REDUCTION 35-MPH AHEAD			1				X																	
NB	7.275	A	W1-2R				RIGHT CURVE			1				X																	
NB	7.395	AB	D3-1				 11/3/17						1			X										TRESTLE LN (TH-50)					
		AB	D3-1	60	12			5.00								2		12'-6" 12'-6" X							INSTALL 10' FROM EDGE OF PAVEMENT		10				
SIGN SUMMARY SHEET							SHEET TOTALS		23.33	0.00	2	1	1	5	0	0	7	95.0			0	0.0	0.0	0.0	0.0	PROJECT NAME: STATEWIDE-SOUTH REGION					
									SF	SF	EA	EA	EA	EA	EA	EA	EA		FT		EA	LB	LB	LB	LB	PROJECT NUMBER: STPG SIGN(57)					
							VERMONT AGENCY OF TRANSPORTATION																						FILE NAME: z16t041Mt HollyVT155 NB.xls		
														TOWN DIRECTIONAL TOTALS		235.3	0.0	10	4	4	56	0	1	50	675.0			0	0.0		
																							DRAWN BY: W. GORDON								
																							CHECKED: BRZEWOSKI								
																							DESIGNED BY: P. MCKECHNIE								
																							MOUNT HOLLY VT-155 NB 8								
																							SHEET 249 OF 264								