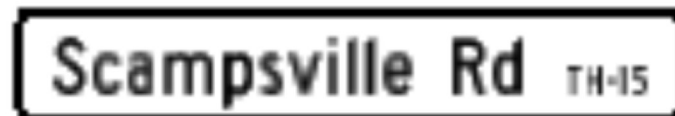
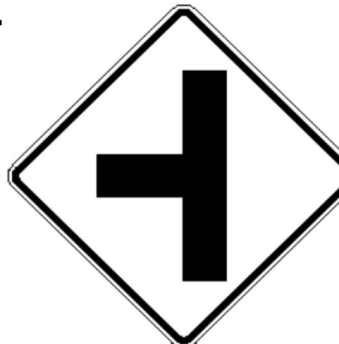
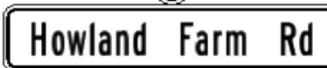


DIRECTION	MILEPOINT	LOCATION CODE (SHEET 4)	SIGN CODE	WIDTH (IN)	HEIGHT (IN)	SHEETING REMARKS	SIGN LEGEND	NEW SIGNS		EXISTING SIGNS				EXIST POST		NUMBER OF NEW POSTS	SQUARE STEEL (IN)			TUBULAR STEEL Ø (IN)				SIGN FRAME REQUIRED	REMARKS	SIGN DETAIL LOCATION			
								"A"	"B"	RETAIN	SALVAGE FROM	SALVAGE TO	REMOVE	RETAIN	REMOVE		1.75	2.00	2.50	FOUNDATION	3.00	3.50	4.00			5.00	SHSM	SIGN DETAILS SHEET #	STANDARD SHEET #
																	(LB / FT)				(LB / FT)								
																	1.88	2.42	3.35		7.60	9.00	10.80			14.60			
SB MT HOLLY VT 155							FY-FLUORESCENT YELLOW FYG-FLUORESCENT YELLOW GREEN															"SHSM"-STANDARD HIGHWAY SIGNS AND MARKINGS BOOK							
SB	3.248	H	R1-1				STOP								X														
		G	VD-700				MILE MARKER 1550/1112/0324				1		1																
		FE	D3-1	68	12		 11/7/17	5.67								2	11'-3" 11'-0" X						INSTALL 10' FROM LLL BETWEEN LLL AND ROAD		10				
		G	VD-700				MILE MARKER 1550/1112/0324					1											INSTALL ON POST CLOSEST TO THE ROAD						
SB	2.709	FE	D3-1				Dana Ln PVT			1				X															
SB	2.580	F	VW-000				MOOSE CROSSING						1		X														
		F	W7-3aP				NEXT 5 MILES						1																
		F	VW-001	30	30		 11/7/17	6.25								1	17'-0" X									T-80			
		F		24	18		 11/7/17	3.00																	4				
SB	2.245	F	VW-054R				 11/27/17						1		X														
		F	VW-054R	30	30			6.25								1	16'-3" X									T-80			
SB	2.207	F	W2-2	30	30		 11/3/17	6.25								1	16'-6" X						INSTALL 200' DOWNSTATION FROM EXISTING SIGN AT MP 2.245	X					
		F	W16-8P	39	8		 11/3/17	2.17																	5				
SB	0.920	F	W7-1a				HILL WARNING 7%						1		X														
		F	W7-3aP				NEXT 1 MILE						1																
SIGN SUMMARY SHEET							SHEET TOTALS		29.58	0.00	1	1	1	7	0	0	5	75.0		0	0.0	0.0	0.0	0.0	PROJECT NAME: STATEWIDE-SOUTH REGION				
									SF	SF	EA	EA	EA	EA	EA	EA	EA		FT		EA	LB	LB	LB	LB	PROJECT NUMBER: STPG SIGN(57)			
																									FILE NAME: z16t041Mt HollyVT155 SB.xls		PLOT DATE: 2/27/2017		
VERMONT AGENCY OF TRANSPORTATION							TOWN DIRECTIONAL TOTALS		171.1	0.0	7	3	3	39	0	0	32	465.0		0	0.0				DRAWN BY: W. GORDON				
																							DESIGNED BY: P. MCKECHNIE		CHECKED: BRZEZOWSKI				
																							MOUNT HOLLY VT-155 SB 5		SHEET 255 OF 264				