
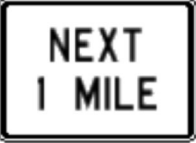
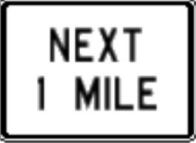







DIRECTION	MILEPOINT	LOCATION CODE (SHEET 4)	SIGN CODE	WIDTH (IN)	HEIGHT (IN)	SHEETING REMARKS	SIGN LEGEND	NEW SIGNS		EXISTING SIGNS				EXIST POST		NUMBER OF NEW POSTS	SQUARE STEEL (IN)			TUBULAR STEEL Ø (IN)				SIGN FRAME REQUIRED	REMARKS	SIGN DETAIL LOCATION			
								"A"	"B"	RETAIN	SALVAGE FROM	SALVAGE TO	REMOVE	RETAIN	REMOVE		1.75	2.00	2.50	FOUNDATION	3.00	3.50	4.00			5.00	SHSM	SIGN DETAILS SHEET #	STANDARD SHEET #
																	(LB / FT)				(LB / FT)								
<b>SB MT HOLLY VT 155</b>							FY-FLUORESCENT YELLOW FYG-FLUORESCENT YELLOW GREEN																"SHSM"-STANDARD HIGHWAY SIGNS AND MARKINGS BOOK						
SB	0.920	F	W7-1a	30	30		 11/3/17 	6.25								1	17'-0" X								X				
		F	W7-3aP	24	18				3.00																	X			
SB	0.445	F	VD-701				 11/2/17 																						
		F	VD-701	6	10				0.42																		INSTALL ON RETAINED POST		T-42
SB	0.450	F	W1-2R	30	30	FY	 11/2/17 	6.25								1	15'-0" X								X		INSTALL 5' UPSTATION FROM GUARDRAIL END TREATMENT AT MP 0.450 SB		
		F	W13-1P	18	18	FY			2.25																	X			
SB	0.124	F	W1-4L	30	30	FY	 11/3/17 	6.25								1	17'-3" X								X		INSTALL 250' DOWNSTATION FROM GUARDRAIL END TREATMENT AT MP 0.170 SB		
		F	W13-1P	18	18	FY			2.25																	X			
SB	0.035	F	W1-2R				RIGHT CURVE																						
		F	W13-1P				40 M.P.H.																						
SB	0.031	G	VD-024				WESTON   MOUNT HOLLY																				INSTALL SIGNS ON NB SIDE OF ROAD (SEE NB MT HOLLY PLANS)		
		G	VD-025				WINDSOR CO   RUTLAND CO																						
		G	VD-700				MILE MARKER 1550/1421/0228																						
		G	VD-700				MILE MARKER 1550/1421/0000																						
<b>SIGN SUMMARY SHEET</b>							<b>SHEET TOTALS</b>	26.67	0.00	0	0	0	7	0	0	3	45.0	0	0.0	0.0	0.0	0.0	PROJECT NAME: STATEWIDE-SOUTH REGION PROJECT NUMBER: STPG SIGN(57)						
VERMONT AGENCY OF TRANSPORTATION							<b>TOWN DIRECTIONAL TOTALS</b>	171.1	0.0	7	3	3	39	0	0	32	465.0	0		0.0			FILE NAME: z16t041Mt HollyVT155 SB.xls PLOT DATE: 2/27/2017 PROJECT MANAGER: D. MUNRO DRAWN BY: W. GORDON DESIGNED BY: P. MCKECHNIE CHECKED: BRZEZOWSKA MOUNT HOLLY VT-155 SB 6 SHEET 256 OF 264						