


# STATE OF VERMONT AGENCY OF TRANSPORTATION

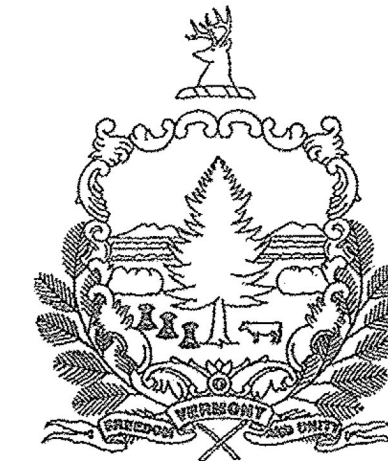

## PROPOSED IMPROVEMENT

**TOWNS OF ST ALBANS TOWN, FAIRFIELD, BAKERSFIELD, CAMBRIDGE, FAIRFAX AND GEORGIA.  
COUNTIES OF FRANKLIN AND LAMOILLE.  
VT RTE 36 (MAJOR COLLECTOR), VT RTE 104 (MINOR ARTERIAL AND MAJOR COLLECTOR)**


STATEWIDE-NORTHWEST SIGN REPLACEMENT - 38.216 MILES

ST ALBANS TOWN (VT 36) MP 0.000 - 5.217, FAIRFIELD (VT 36) MP 0.000 - 9.989,  
BAKERSFIELD (VT 36) MP 0.000 - 2.507


CAMBRIDGE (VT 104) MP 0.000 - 1.967, FAIRFAX (VT 104) MP 0.000 - 14.185,  
GEORGIA (VT 104) MP 0.000 - 0.130, FAIRFIELD (VT 104) MP 0.000 - 0.111,  
ST ALBANS TOWN (VT 104) MP 0.000 - 4.110

WORK TO BE PERFORMED INCLUDES THE REMOVAL OF EXISTING SIGNS AND POSTS  
AND THE INSTALLATION OF NEW SIGNS AND POSTS AND OTHER HIGHWAY RELATED ITEMS.

PROJECT LOCATION  
STATEWIDE-NORTHWEST  
STPG SIGN (58)

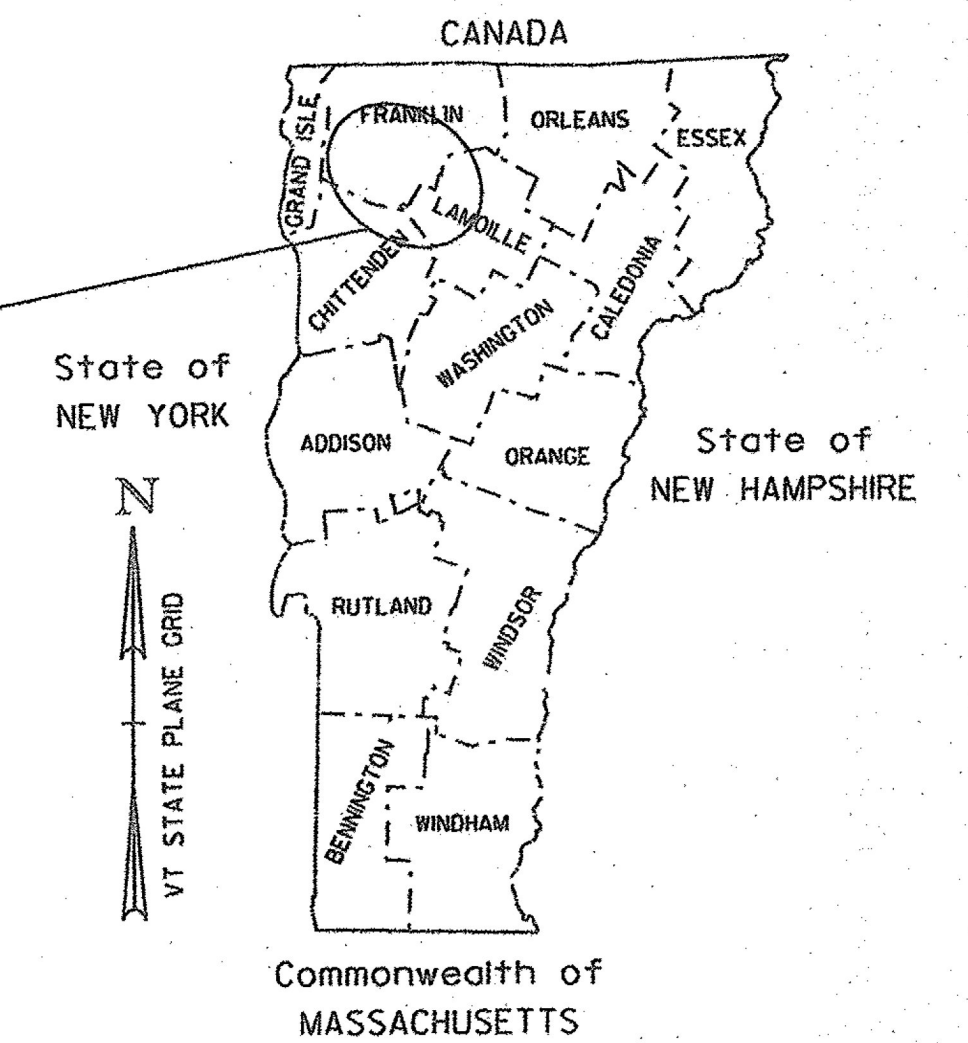

RECORD PLANS	
CONTRACTOR:	F. R. LAFAYETTE, INC. - ESSEX JUNCTION, VT
RESIDENT ENGINEER:	CHRIS LAVALETTE
CONSTRUCTION BEGAN:	SEPTEMBER 11, 2017
CONSTRUCTION COMPLETE:	APRIL 13, 2018
RECORD PLANS BY:	CHRIS LAVALETTE & JESSE IVES
I HEREBY CERTIFY THAT ALL THE CONSTRUCTION REQUIRED BY THIS SET OF DRAWINGS HAS BEEN ACCOMPLISHED AS INDICATED HEREIN.	
BY	RESIDENT ENGINEER
DATE 10/26/18	
NOTE: Any further information concerning final quantities, amounts or other details relative to this project may be found by contacting Vtrans Records Management.	

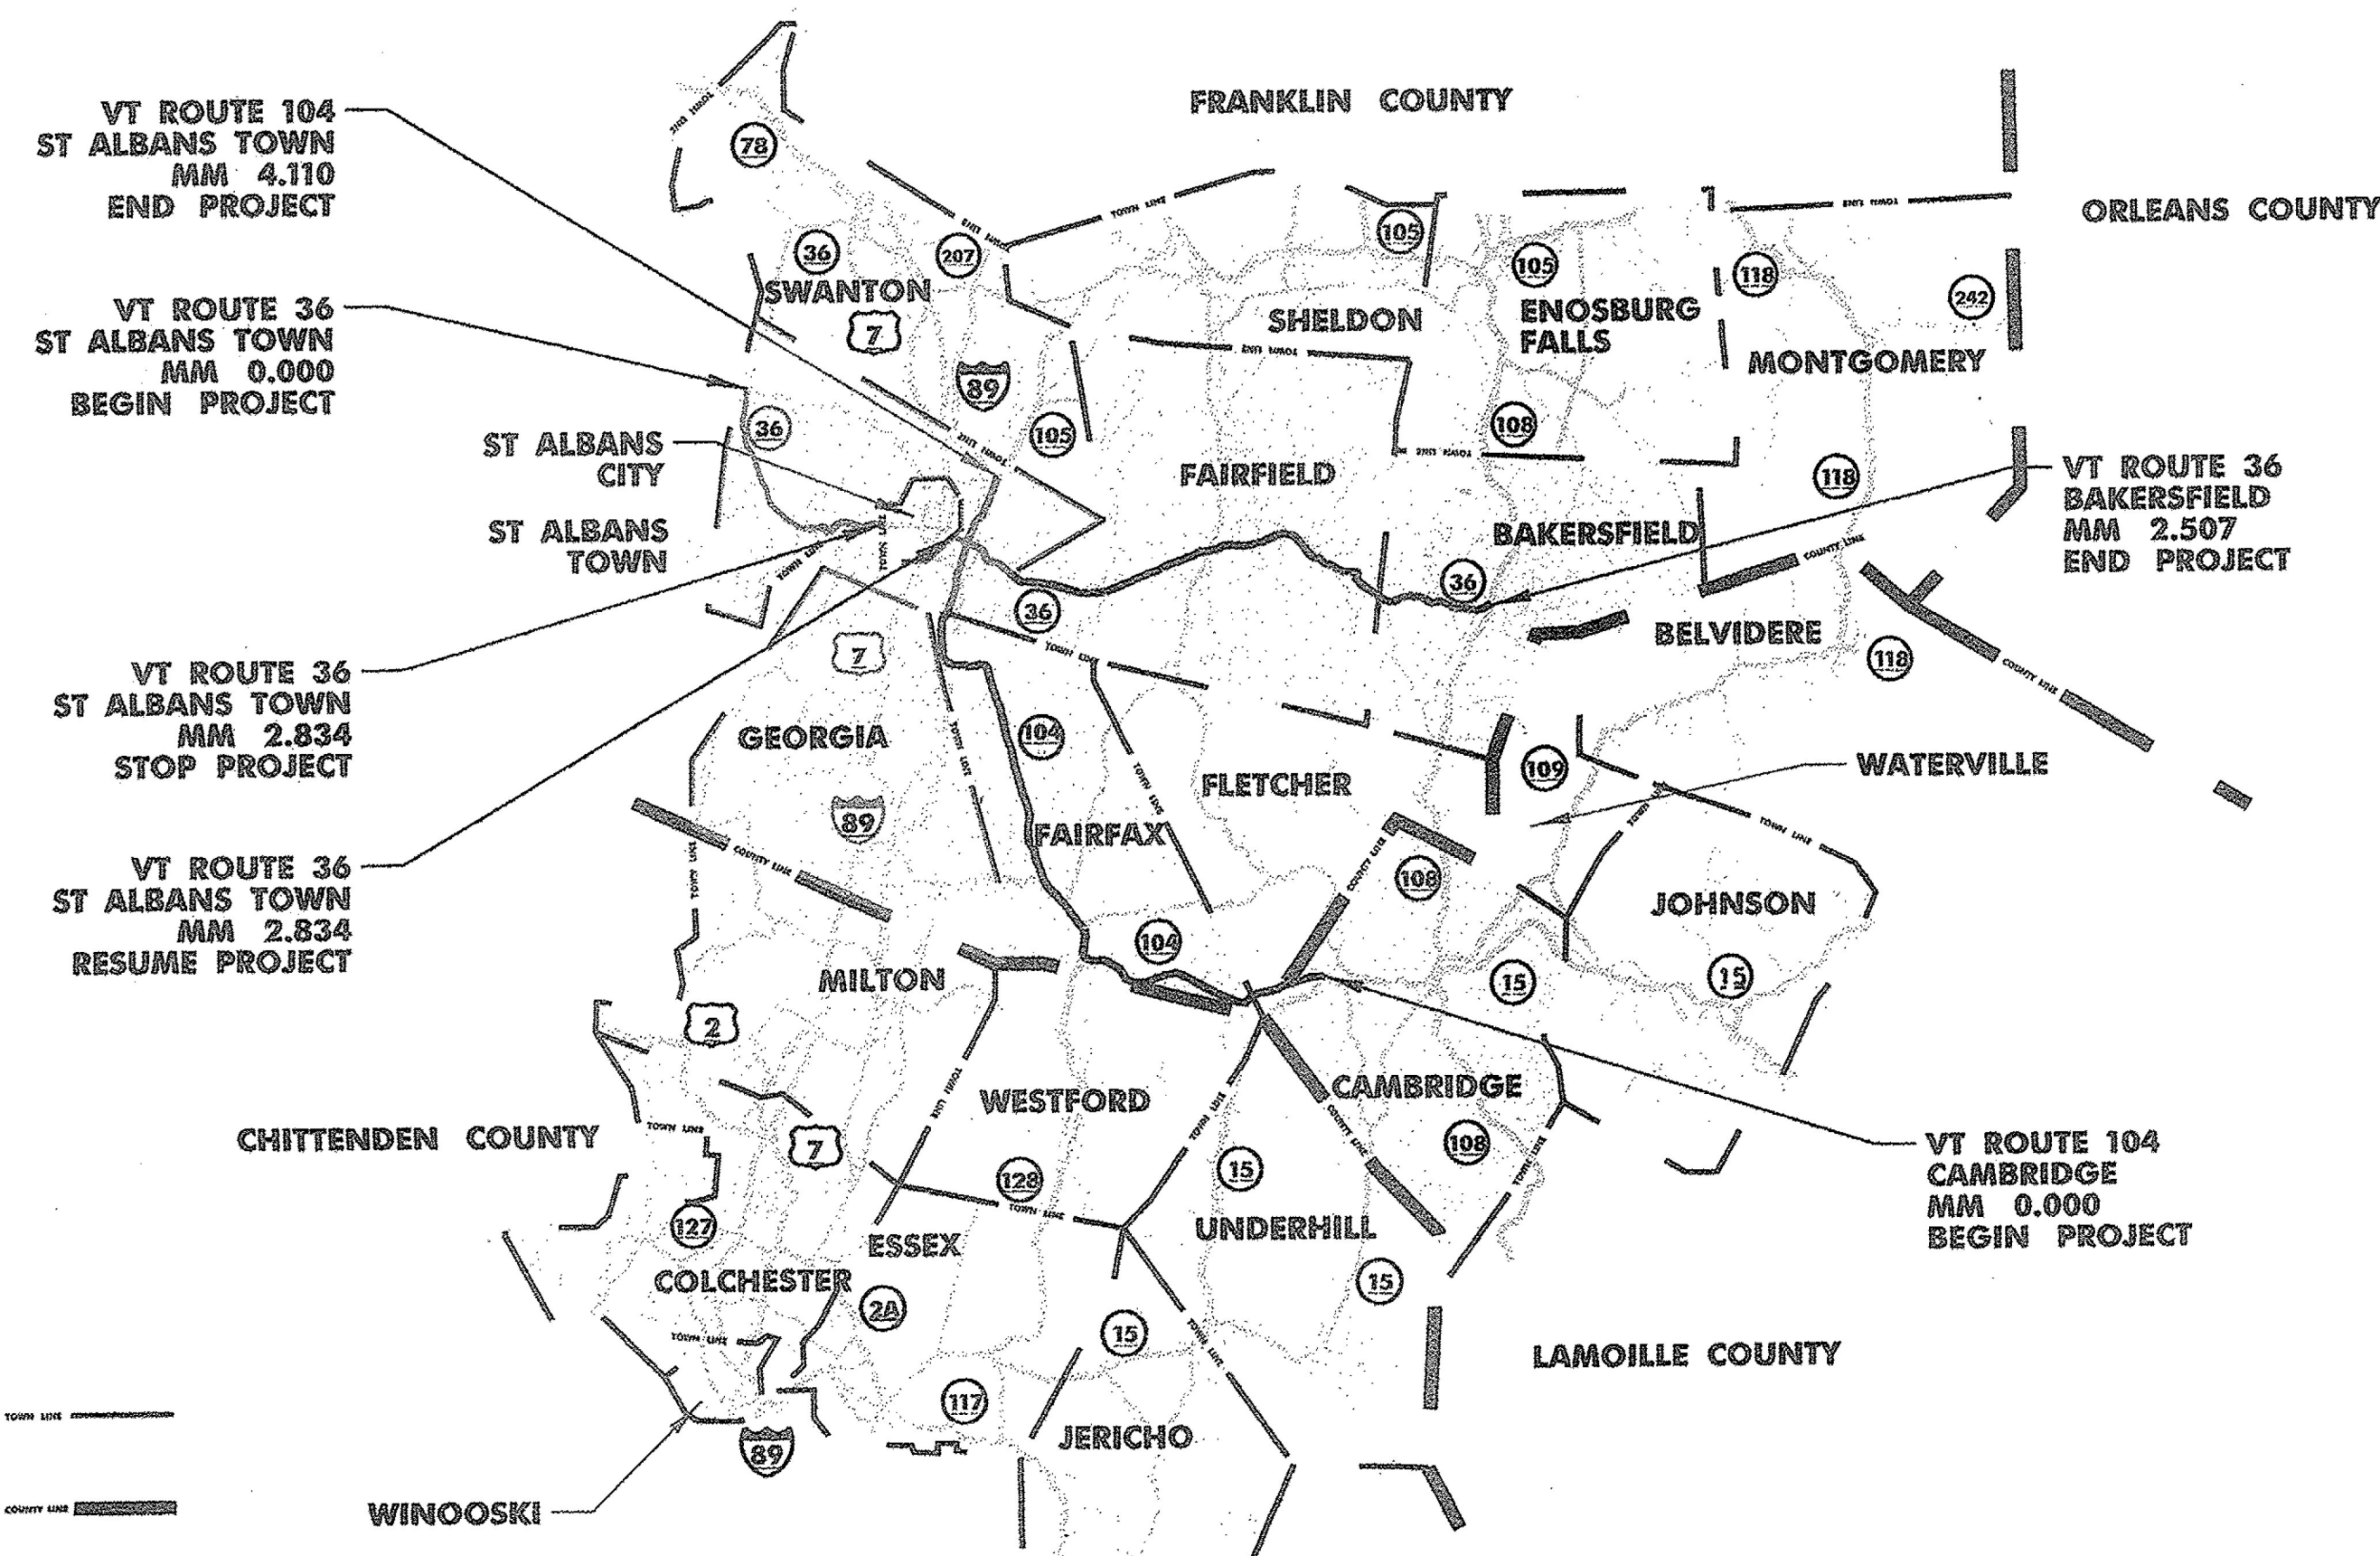


CONSTRUCTION IS TO BE CARRIED ON IN ACCORDANCE WITH THESE PLANS AND THE STANDARD SPECIFICATIONS FOR CONSTRUCTION DATED 2011, AS APPROVED BY THE FEDERAL HIGHWAY ADMINISTRATION ON JULY 20, 2011 FOR USE ON THIS PROJECT, INCLUDING ALL SUBSEQUENT REVISIONS AND SUCH REVISED SPECIFICATIONS AND SPECIAL PROVISIONS AS ARE INCORPORATED IN THESE PLANS.

QUALITY ASSURANCE PROGRAM : LEVEL 3
SURVEYED BY : N/A
SURVEYED DATE : N/A
DATUM
VERTICAL N/A
HORIZONTAL N/A

TOWN LINE

COUNTY LINE

**DuBois & King**  
INC.

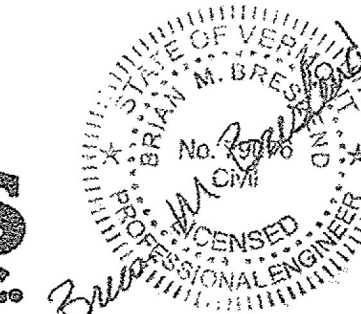

DIRECTOR OF PROJECT DELIVERY	APPROVED	DATE 3/13/2017
PROJECT MANAGER : MICHAEL LACROIX		
PROJECT NAME : STATEWIDE-NORTHWEST		
PROJECT NUMBER : STPG SIGN (58)		
SHEET 1 OF 146 SHEETS		