




VT 104 – FAIRFAX SB

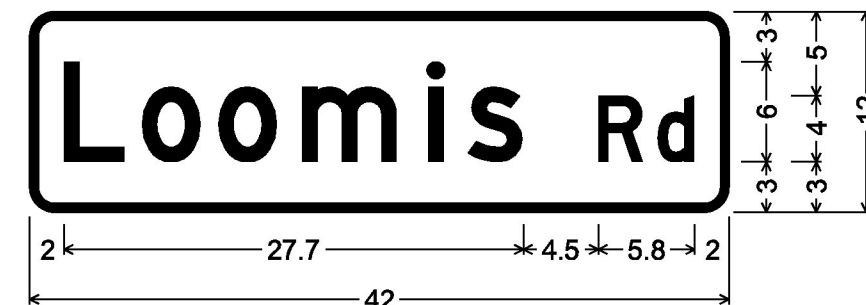

DOUBLE - SIDED STREET SIGN (FAIRFAX);
1.5" Radius, 0.5" Border, White on Green;
[Loomis Rd] D;

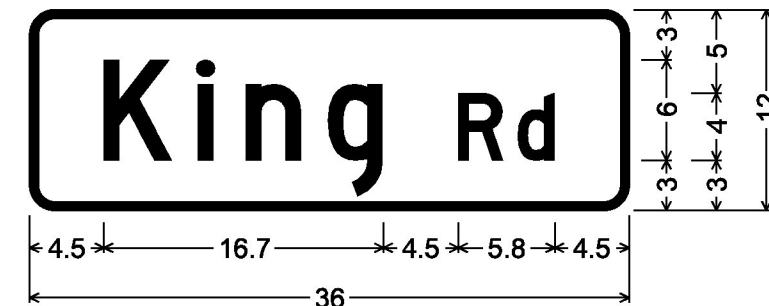


DOUBLE - SIDED STREET SIGN (FAIRFAX);
1.5" Radius, 0.5" Border, White on Green;
[King Rd] D;

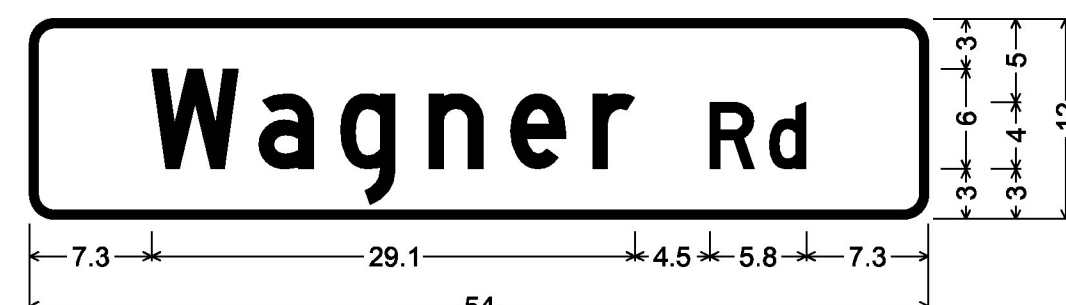


DOUBLE - SIDED STREET SIGN (FAIRFAX);
1.5" Radius, 0.5" Border, White on Green;
[Wagner Rd] D;




DOUBLE - SIDED STREET SIGN (FAIRFAX);
1.5" Radius, 0.5" Border, White on Green;
[Rocky Ridge Rd] D;

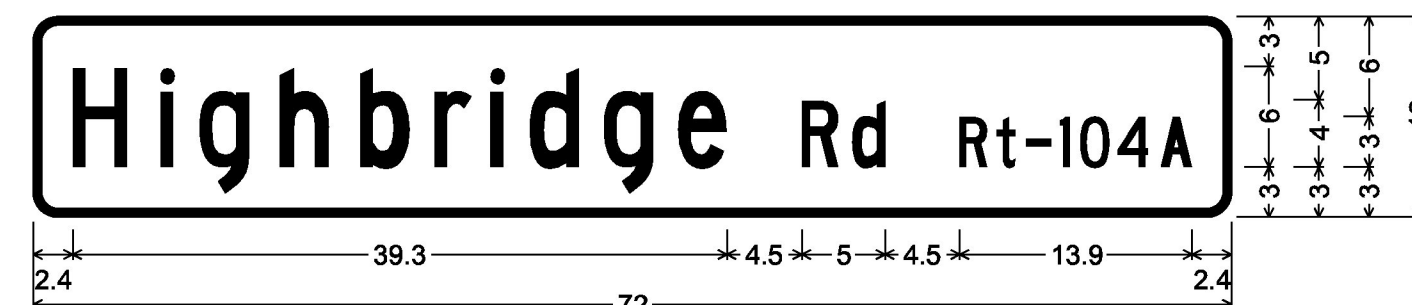


DOUBLE - SIDED STREET SIGN (FAIRFAX);
1.5" Radius, 0.5" Border, White on Green;
[Highbridge] C [Rd] C [Rt-104A] C;

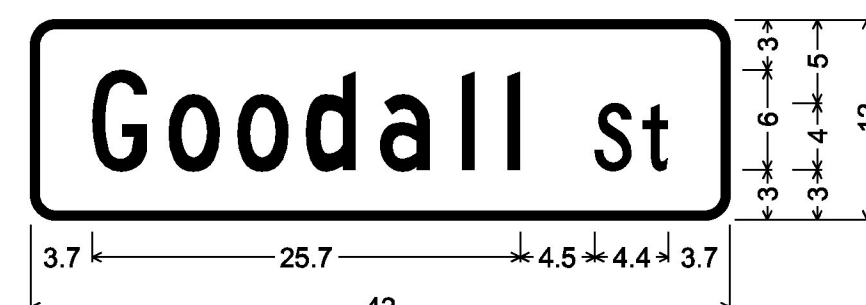


DOUBLE - SIDED STREET SIGN (FAIRFAX);
1.5" Radius, 0.5" Border, White on Green;
[Goodall] C [St] C;

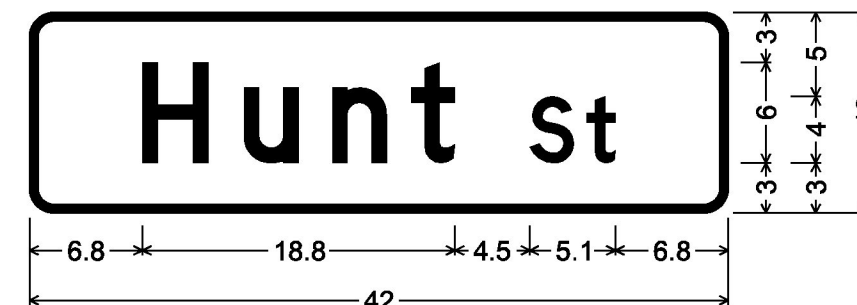


DOUBLE - SIDED STREET SIGN (FAIRFAX);
1.5" Radius, 0.5" Border, White on Green;
[Hunt St] D;

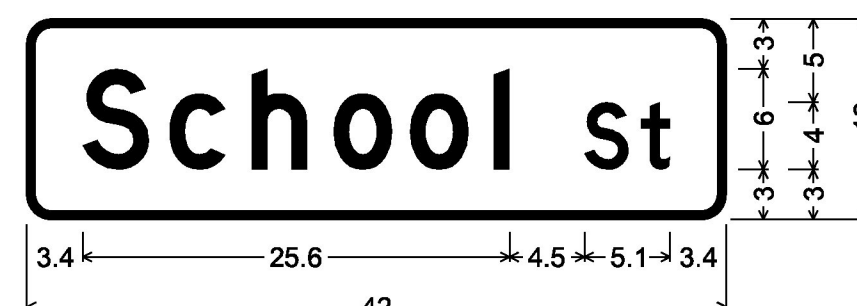

DOUBLE - SIDED STREET SIGN (FAIRFAX);
1.5" Radius, 0.5" Border, White on Green;
[School St] D;

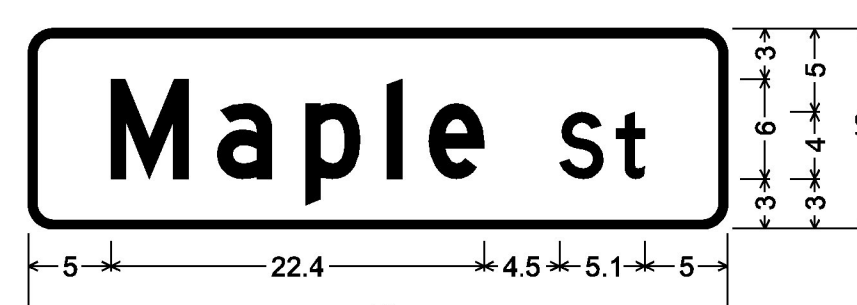


DOUBLE - SIDED STREET SIGN (FAIRFAX);
1.5" Radius, 0.5" Border, White on Green;
[Maple St] D;

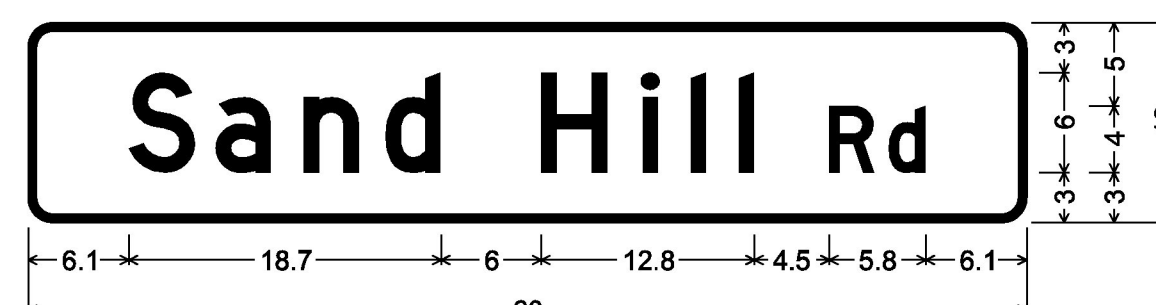

DOUBLE - SIDED STREET SIGN (FAIRFAX);
1.5" Radius, 0.5" Border, White on Green;
[Sand Hill Rd] D;



DOUBLE - SIDED STREET SIGN (FAIRFAX);
1.5" Radius, 0.5" Border, White on Green;
[Plains Rd] D;

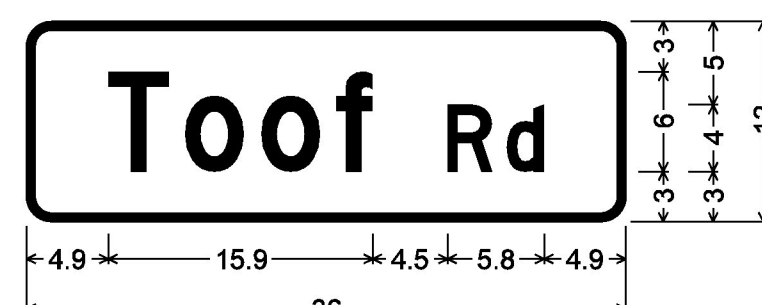

DOUBLE - SIDED STREET SIGN (FAIRFAX);
1.5" Radius, 0.5" Border, White on Green;
[Toof Rd] D;



DOUBLE - SIDED STREET SIGN (FAIRFAX);
1.5" Radius, 0.5" Border, White on Green;
[Allen Irish Rd] D;

ALL SIGNS IN THIS SHEET ARE SIGN CODE VD3-1

PROJECT NAME:	STATEWIDE-NORTHWEST
PROJECT NUMBER:	STPG SIGN (58)
FILE NAME:	z16T042tsss-def.dgn
PROJECT LEADER:	B. BRESLEND
DESIGNED BY:	O. DALMER
SIGN DETAIL SHEET	6
PLOT DATE:	3/10/2017
DRAWN BY:	O. DALMER
CHECKED BY:	C. LATHROP
SHEET	10 OF 146