






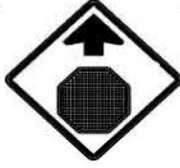

DIR	MILEPOINT	LOCATION CODE	MUTCD CODE	WIDTH	HEIGHT	SHEETING REMARKS	SIGN LEGEND	NEW SIGNS		EXISTING SIGNS			EXIST POST		NUMBER OF NEW POSTS	SQUARE STEEL (in)			TUBULAR STEEL Ø (IN)				SIGN FRAME REQUIRED	REMARKS	SIGN DETAIL			
								"A"	"B"	RETAIN	SALVAGE FROM	SALVAGE TO	REMOVE	RETAIN		REMOVE	1.75	2.00	2.50	3.00	3.50	4.00			5.00	DETAIL IN SHSM	DETAIL ON SHEET NUMBER	DETAIL ON STD SHEET NUMBER
																	(LB / FT)			(LB / FT)								
							FYG-FLUORESCENT YELLOW-GREEN															"SHSM" - STANDARD HIGHWAY SIGNS AND MARKINGS						
EB	2.320	A	VD-062B	72	16		BAKERSFIELD ==>>			1													COUNTRY CLUB 2					
EB	2.344	A	W3-1	30	30		STOP AHEAD																					
		A	W3-1	36	36			9.00															REQUIRES VEGETATION CLEARING	X				
EB	2.414	A	M2-1	24	12		 	2.00															GREEN ON WHITE	X				
		A	VM1-5	30	24		 	5.00															INSTALL SIGN ASSEMBLY 80 FEET WEST OF EXISTING SIGN ASSEMBLY			E-136B		
		A	M4-6	24	12			2.00															GREEN ON WHITE	X				
		A	VM1-5	24	24			4.00															REQUIRES VEGETATION CLEARING			E-136B		
EB	2.429	A	M2-1	24	12		JCT																					
		A	VM1-5	30	24		VT 108																					
		A	M4-6	24	12		END																					
		A	VM1-5	24	24		VT 36																					
EB	2.459	A	VD1-1A	72	12			6.00															INSTALL SIGN ASSEMBLY 25 FEET WEST OF EXISTING SIGN ASSEMBLY			T-93		
		A	VD2-1	72	12			6.00															MOVED 83' DRIVEWAY AT 25'			T-93		
EB	2.464	A	VD1-1A	72	10		<---- ENOSBURG FALLS 9																					
		A	VD2-1	72	10		JEFFERSONVILLE 11																					
<b>SIGN SUMMARY SHEET</b>							SHEET TOTALS	34.00	0.00	1	0	0	7	2	5	6								PROJECT NAME: STATEWIDE- NORTHWEST				
								SF	SF	EA	EA	EA	EA	EA	EA	EA								PROJECT NUMBER: STPG SIGN (58)				
																								FILE NAME: z16t042vt36-BAKERSFIELD EB.	PLOT DATE: 3/10/2017			
VERMONT AGENCY OF TRANSPORTATION							TOWN TOTALS	79.50	0.00	4	1	3	14	4	11	18								PROJECT MANAGER: B. BRESLEND	DRAWN BY: O. DALMER			
																							DESIGNED BY: O. DALMER	CHECKED BY: B. BRESLEND				
																								BAKERSFIELD VT36 EB 2	SHEET 67	OF 146		