
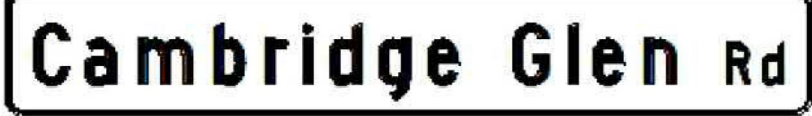
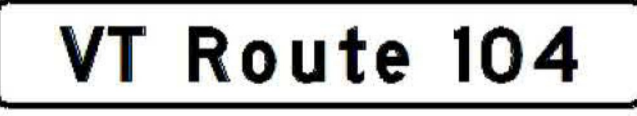



DIR	MILEPOINT	LOCATION CODE	MUTCD CODE	WIDTH	HEIGHT	SHEETING REMARKS	SIGN LEGEND	NEW SIGNS		EXISTING SIGNS				EXIST POST		NUMBER OF NEW POSTS	SQUARE STEEL (in)			TUBULAR STEEL Ø (IN)				SIGN FRAME REQUIRED	REMARKS	SIGN DETAIL		
								"A"	"B"	RETAIN	SALVAGE FROM	SALVAGE TO	REMOVE	RETAIN	REMOVE		1.75	2.00	2.50	3.00	3.50	4.00	5.00			DETAIL IN SHSM	DETAIL ON SHEET NUMBER	DETAIL ON STD SHEET NUMBER
																	(LB / FT)			(LB / FT)								
	CAMBRIDGE	VT104	SB				FYG-FLUORESCENT YELLOW-GREEN															"SHSM" - STANDARD HIGHWAY SIGNS AND MARKINGS						
SB	1.860	F	VD3-1	30	6		SUGARHOUSE DR			1													PRIVATE DRIVE					
SB	1.235	F	VD3-1	30	6		PINECREST DR PVT			1													PRIVATE DRIVE					
SB	1.140	F	VD3-1	36	6		FRONTENAC WAY PVT			1													PRIVATE DRIVE					
SB	0.900	F	VD3-1	42	12		BLUE JAY DR PVT			1													TH 71					
SB	0.685	F	VD3-1	36	6		BOYDEN HILL DR PVT			1													PRIVATE DRIVE					
SB	0.445	G	VR-017	24	30		LLL 24,000 LBS																SIGN NOT THERE					
			G	VR-017	24	30		5.00																		T-70		
SB	0.440	F	VD3-1	30	6		GOODYEAR LN			1													TH7 71					
SB	0.355	G	VD3-1	24	6		VT RTE 104																TH 88					
		F	VD3-1	42	6		CAMBRIDGE GLEN RD																TH 88					
		F	VD3-1	72	12			6.00															TH 88		8			
SB	0.350	G	VD3-1	66	12			5.50															TH 88. INSTALL STREET SIGN 25 FEET NORTH OF CAMBRIDGE GLEN ROAD		8			
SB	0.352	G	VR-017	24	30		LLL 24,000 LBS																TH 88					
		G	VR-017	24	30			5.00															TH 88			T-70		
SB	0.345	H	R1-1	30	30		STOP																TH 88					
SIGN SUMMARY SHEET							SHEET TOTALS	21.50	0.00	6	0	0	5	7	4	6	90							PROJECT NAME: STATEWIDE- NORTHWEST				
VERMONT AGENCY OF TRANSPORTATION								SF	SF	EA	EA	EA	EA	EA	EA	EA	EA	FT						PROJECT NUMBER: STPG SIGN (58)				
							TOWN TOTALS	89.19	0.00	12	1	1	17	11	11	14	210						FILE NAME: z16T042 VT104-CAMBRIDGE S	PLOT DATE: 3/10/2017				
													4				76.75					PROJECT MANAGER: B. BRESLEND	DRAWN BY: O. DALMER					
																						DESIGNED BY: O. DALMER	CHECKED BY: B. BRESLEND					
																						CAMBRIDGE VT104 SB 1	SHEET 74	OF	146			