
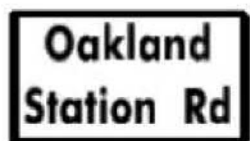



DIR	MILEPOINT	LOCATION CODE	MUTCD CODE	WIDTH	HEIGHT	SHEETING REMARKS	SIGN LEGEND	NEW SIGNS		EXISTING SIGNS			EXIST POST		NUMBER OF NEW POSTS	SQUARE STEEL (in)			TUBULAR STEEL Ø (IN)				SIGN FRAME REQUIRED	REMARKS	SIGN DETAIL			
								"A"	"B"	RETAIN	SALVAGE FROM	SALVAGE TO	REMOVE	RETAIN		REMOVE	1.75	2.00	2.50	3.00	3.50	4.00			5.00	DETAIL IN SHSM	DETAIL ON SHEET NUMBER	DETAIL ON STD SHEET NUMBER
																	(LB / FT)			(LB / FT)								
	FAIRFAX		VT104	NB			FYG-FLUORESCENT YELLOW-GREEN															"SHSM" - STANDARD HIGHWAY SIGNS AND MARKINGS						
NB	12.658	A	VD3-1	20	6		STABLE RD			1			1										PRIVATE ROAD					
NB	13.058	A	VD3-1	30	6		MURREY RD PVT RD			1			1										PRIVATE ROAD					
NB	13.233	A	W1-10R	36	36		MODIFIED RIGHT CURVE						1															
		A	W16-8aP	36	18		OAKLAND STATION RD						1															
NB	13.273	A	VW-133R	30	30		HIDDEN DRIVE RIGHT						4	4	1								USE RETAINED POST FOR NEW SIGN ASSEMBLY					
		A	W1-10R	36	36			9.00					2	4		14.50 X 15.25								X				
		A	W16-8aP	36	15			3.75																	12			
NB	13.313	A	VW-133R	30	30			6.25					1			13.50 X							INSTALL SIGN ASSEMBLY 200 FEET NORTH OF EXISTING ASSEMBLY			T-81		
NB	13.353	C	VD-024	60	7.5		GEORGIA / FAIRFAX					1																
NB	13.488	A	VD3-1	42	9		IRONWOOD RD PVT RD			1			1										PRIVATE ROAD					
NB	13.503	C	VD-024	60	7.5		FAIRFAX / GEORGIA					1																
		C	VD-700	6	10		MM 0104, 0604, 0000					1																
		C	VD-700	6	10		MM 0104, 0608, 0013					1																
							GEORGIA VT 104 SEGMENT																					
NB	13.594	C	VD-024	72	10			5.00					2			14.75 X 14.00							INSTALL SIGN ASSEMBLY 1170 FEET NORTH FROM EXISTING SIGN AT MM. 13.503			T-93		
SIGN SUMMARY SHEET							SHEET TOTALS	24.00	0.00	3	0	0	7	4	4	4	60						PROJECT NAME: STATEWIDE- NORTHWEST					
								SF	SF	EA	EA	EA	EA	EA	EA	EA	FT					PROJECT NUMBER: STPG SIGN (58)						
VERMONT AGENCY OF TRANSPORTATION							TOWN TOTALS	500.47	0.00	53	12	14	117	67	60	69	1035						FILE NAME: z16T042 VT104-FAIRFAX NB.xl	PLOT DATE: 3/10/2017				
												6	3	5	5	72.00						PROJECT MANAGER: B. BRESLEND	DRAWN BY: O. DALMER					
																						DESIGNED BY: O. DALMER	CHECKED BY: B. BRESLEND					
																						FAIRFAX VT104 NB 18	SHEET 94	OF 146				