



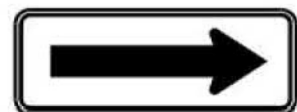


DIR	MILEPOINT	LOCATION CODE	MUTCD CODE	WIDTH	HEIGHT	SHEETING REMARKS	SIGN LEGEND	NEW SIGNS		EXISTING SIGNS			EXIST POST		NUMBER OF NEW POSTS	SQUARE STEEL (in)			TUBULAR STEEL Ø (IN)				SIGN FRAME REQUIRED	REMARKS	SIGN DETAIL				
								"A"	"B"	RETAIN	SALVAGE FROM	SALVAGE TO	REMOVE	RETAIN		REMOVE	1.75	2.00	2.50	FOUNDATION	3.00	3.50			4.00	5.00	DETAIL IN SHSM	DETAIL ON SHEET NUMBER	DETAIL ON STD SHEET NUMBER
																	(LB / FT)				(LB / FT)								
	<b>FAIRFAX</b>		<b>VT104</b>	<b>SB</b>			FYG-FLUORESCENT YELLOW-GREEN															"SHSM" - STANDARD HIGHWAY SIGNS AND MARKINGS							
SB	9.668	G	VR-017	24	30		LLL 24,000 LBS			1			1										TH 14						
SB	9.663	F	VD3-1	24	6		WAGNER RD						1										TH 14						
		H	R1-1	30	30		STOP			1			1										TH 14						
		G	VD-700	6	10		MM 0104, 0604, 0984			1													TH 14						
SB	9.663	F	VD3-1	54	12			4.50						2			14.00 X 14.25						TH 14. INSTALL SIGN ON SEPARATE POSTS IN EXISTING LOCATION AND A MINIMUM OF 10 FT FROM STOP SIGN		10				
SB	8.638	F	VD3-1	24	6		ANDBRON RD			1			1										PRIVATE ROAD						
SB	8.543	F	VD3-1	30	6		MISTY GLEN RD PVT			1			1										PRIVATE ROAD						
SB	7.838	F	VS3-1	30	30		SCHOOL BUS STOP AHEAD						1	2															
		F	VW-133L	30	30		HIDDEN DRIVE LEFT							1															
		F	W1-2L	30	30			6.25															X						
		F	VW-133L	30	30			6.25																		T-81			
SB	7.781	F	W1-6L	48	24		<== LEFT						1	2			27.25 X						LARGE ARROW MOVED FURTHER AWAY FROM OTHER ARROW						
		F	W1-6L	48	24			8.00		1	1	1											X						
SB	7.779	E	W1-6R	48	24		==> RIGHT						1	2	2		14.25 X 12.75		REPLACED BOTH POSTS				LARGE ARROW						
		E	W1-6R	48	24			8.00															X						
<b>SIGN SUMMARY SHEET</b>							SHEET TOTALS	33.00	0.00	5	0	0	5	10	0	2		30						PROJECT NAME: STATEWIDE- NORTHWEST					
VERMONT AGENCY OF TRANSPORTATION							TOWN TOTALS	636.46	0.00	50	13	11	134	62	79	92		1380						PROJECT NUMBER: STPG SIGN (58)					
								SF	SF	EA	EA	EA	EA	EA	EA	EA		FT					FILE NAME: z16T042 VT104-FAIRFAX SB.xl	PLOT DATE: 3/10/2017					
													6	8	2	4		82.50					PROJECT MANAGER: B. BRESLEND	DRAWN BY: O. DALMER					
																							DESIGNED BY: O. DALMER	CHECKED BY: B. BRESLEND					
																							FAIRFAX VT104 SB 5	SHEET 100 OF 146					