

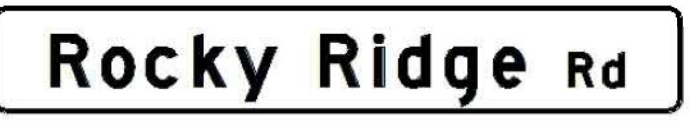



DIR	MILEPOINT	LOCATION CODE	MUTCD CODE	WIDTH	HEIGHT	SHEETING REMARKS	SIGN LEGEND	NEW SIGNS		EXISTING SIGNS			EXIST POST		NUMBER OF NEW POSTS	SQUARE STEEL (in)			TUBULAR STEEL Ø (IN)				SIGN FRAME REQUIRED	REMARKS	SIGN DETAIL			
								"A"	"B"	RETAIN	SALVAGE FROM	SALVAGE TO	REMOVE	RETAIN		REMOVE	1.75	2.00	2.50	3.00	3.50	4.00			5.00	DETAIL IN SHSM	DETAIL ON SHEET NUMBER	DETAIL ON STD SHEET NUMBER
																	(LB / FT)			(LB / FT)								
	FAIRFAX		VT104	SB			FYG-FLUORESCENT YELLOW-GREEN															"SHSM" - STANDARD HIGHWAY SIGNS AND MARKINGS						
SB	7.743	F	W1-6L	48	24		<== LEFT			1													LARGE ARROW					
SB	7.741	E	W1-6R	48	24		RIGHT ==>			1													LARGE ARROW					
SB	7.643	F	VD3-1	30	6		LAPIERRE RD			1													PRIVATE ROAD					
SB	7.353	F	S3-1	30	30		SCHOOL BUS STOP AHEAD																					
		F	W13-1P	24	24		40 MPH																					
SB	7.323	F	W1-10L	30	30		MODIFIED LEFT CURVE																RETAIN DELINEATORS THROUGH THIS AREA					
		F	W13-1P	24	24		40 MPH		1																			
		F	W16-8aP	30	15		ROCKY RIDGE ROAD																					
		F	W1-10L	36	36			9.00															REQUIRES VEGETATION CLEARING	X				
		F	W16-8aP	30	15			3.13																	12			
SB	7.268	G	VR-017	24	30		LLL 24,000 LBS			1	1	1	1	1										TH 22				
																								DAMAGED POST REPLACED				
SB	7.263	H	R1-1	30	30		STOP																	TH 22				
		G	VD-700	6	10		MM 0104, 0604, 0740			1	1	1	1											TH 22				
		F	VD3-1	72	12			6.00																TH 22		10		
		H	R1-1	30	30			6.25																TH 22	X			
SIGN SUMMARY SHEET							SHEET TOTALS	24.38	0.00	6	0	0	5	7	4	4	15							PROJECT NAME: STATEWIDE- NORTHWEST				
								SF	SF	EA	EA	EA	EA	EA	EA	EA	FT						PROJECT NUMBER: STPG SIGN (58)					
VERMONT AGENCY OF TRANSPORTATION							TOWN TOTALS	636.46	0.00	50	13	11	134	62	79	92	1380							FILE NAME: z16T042 VT104-FAIRFAX SB.xl	PLOT DATE: 3/10/2017			
										2	2	7	6	2	3	54.00							PROJECT MANAGER: B. BRESLEND	DRAWN BY: O. DALMER				
																							DESIGNED BY: O. DALMER	CHECKED BY: B. BRESLEND				
																							FAIRFAX VT104 SB 6	SHEET 101 OF 146				