




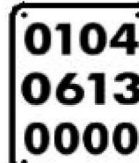


DIR	MILEPOINT	LOCATION CODE	MUTCD CODE	WIDTH	HEIGHT	SHEETING REMARKS	SIGN LEGEND	NEW SIGNS		EXISTING SIGNS			EXIST POST		NUMBER OF NEW POSTS	SQUARE STEEL (in)			TUBULAR STEEL Ø (IN)				SIGN FRAME REQUIRED	REMARKS	SIGN DETAIL			
								"A"	"B"	RETAIN	SALVAGE FROM	SALVAGE TO	REMOVE	RETAIN		REMOVE	1.75	2.00	2.50	3.00	3.50	4.00			5.00	DETAIL IN SHSM	DETAIL ON SHEET NUMBER	DETAIL ON STD SHEET NUMBER
																	(LB / FT)			(LB / FT)								
												FOUNDATION																
ST ALBANS TOWN			VT104	NB			FYG-FLUORESCENT YELLOW-GREEN														"SHSM" - STANDARD HIGHWAY SIGNS AND MARKINGS							
NB	0.000	C	VD-024	72	10		ST ALBANS / FAIRFIELD			1																		
		C	VD-700	6	10		 	0.42																	T-44			
		C	VD-700	6	10			0.42																	T-44			
NB	0.167	A	S3-1	30	30		SCHOOL BUS STOP AHEAD																					
NB	0.392	A	VD3-1	42	6		HOLYOKE FARM DR PVT RD																		PRIVATE ROAD			
		A	VD3-1	72	12			6.00																	PRIVATE ROAD	11		
NB	0.614	A	W3-5	36	36		SPEED REDUCTION SL 40																					
NB	0.642	A	W3-5	36	36			9.00																	INSTALL SIGN 150 FT NORTH OF EXISTING SIGN. REQUIRES VEGETATION CLEARING	X		
NB	0.737	A	R2-1	24	30		SPEED LIMIT 40																					
		A	R2-1	30	36			7.50																		X		
NB	1.027	A	VD3-1	30	12		TROMBLY RD			1															PRIVATE ROAD			
NB	1.227	A	R2-1	24	30		SPEED LIMIT 40			1																		
		A	R8-3a	24	24		NO PARKING			1																SYMBOL		
		A	VR-644	24	12		BEGIN																			REQUIRES VEGETATION CLEARING		
		A	M4-14	24	12			2.00																		RED ON WHITE	X	
SIGN SUMMARY SHEET							SHEET TOTALS	25.34	0.00	4	0	0	5	5	4	4	60	0	0									
VERMONT AGENCY OF TRANSPORTATION							TOWN TOTALS	327.93	0.00	62	3	3	80	40	33	40	600	2	247									
PROJECT NAME: STATEWIDE- NORTHWEST																					PROJECT NUMBER: STPG SIGN (58)							
FILE NAME: z16T042 VT104-ST ALBANS NI																		PLOT DATE: 3/10/2017										
PROJECT MANAGER: B. BRESLEND																		DRAWN BY: O. DALMER										
DESIGNED BY: O. DALMER																		CHECKED BY: B. BRESLEND										
ST ALBANS TOWN VT104 NB 1																					SHEET 120 OF 146							