

INDEX OF SHEETS

- 1 TITLE SHEET
- 2 QUANTITY SHEET
- 3 TRAFFIC CONTROL PLAN
- 4 MISCELLANEOUS DETAILS SHEET
- 5-7 ROAD QUANTITY SHEETS 1-4
- 8 ROAD SUMMARY SHEET
- 9-18 CLASS 2 TOWN HIGHWAY QUANTITY SHEETS 1-10

VAOT STANDARDS

- E-192 10/12/2000
- E-193 08/18/1995
- T-1 04/25/2016
- T-11 08/06/2012
- T-12 08/06/2012
- T-22 08/06/2012
- T-23 08/06/2012
- T-24 08/06/2012
- T-28 08/06/2012
- T-29 08/06/2012
- T-31 08/06/2012

Record Plans

Contractor: L & D SAFETY MARKING CORPORATION
 Resident Engineer: SETH HISMAN
 Construction Began: JUNE 5, 2017
 Construction Complete: OCTOBER 20, 2017
 Record Plans By: SETH HISMAN & JESSE IVES

I hereby certify that all construction required by this set of drawings has been accomplished as indicated herein.

BY:  on 2018-08-30 11:38:29 GMT Resident Engineer

Date: August 30, 2018

NOTE: Any further information concerning final quantities, amounts or other details relative to this project may be found at Central Files in the electronic archives.




STATE OF VERMONT AGENCY OF TRANSPORTATION



PROPOSED IMPROVEMENT STATEWIDE - NORTHEAST REGION NATIONAL HIGHWAY SYSTEM, STATE ROAD, CLASS 1 & CLASS 2 TOWN HIGHWAYS

APPLICATION OF CENTER LINE, EDGE LINE AND LANE LINE MARKINGS ON NATIONAL HIGHWAY AND STATE SYSTEM ROADS. APPLICATION OF CENTER LINE MARKINGS ONLY ON CLASS 1 AND CLASS 2 TOWN HIGHWAYS WITHIN CALEDONIA, ESSEX, ORANGE, ORLEANS, AND WASHINGTON COUNTIES.

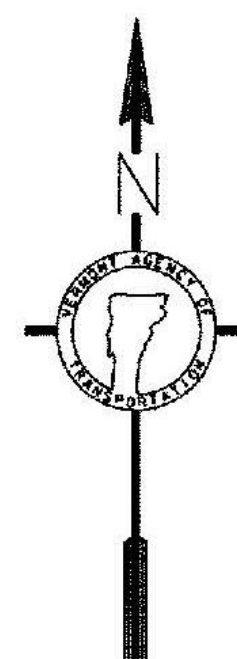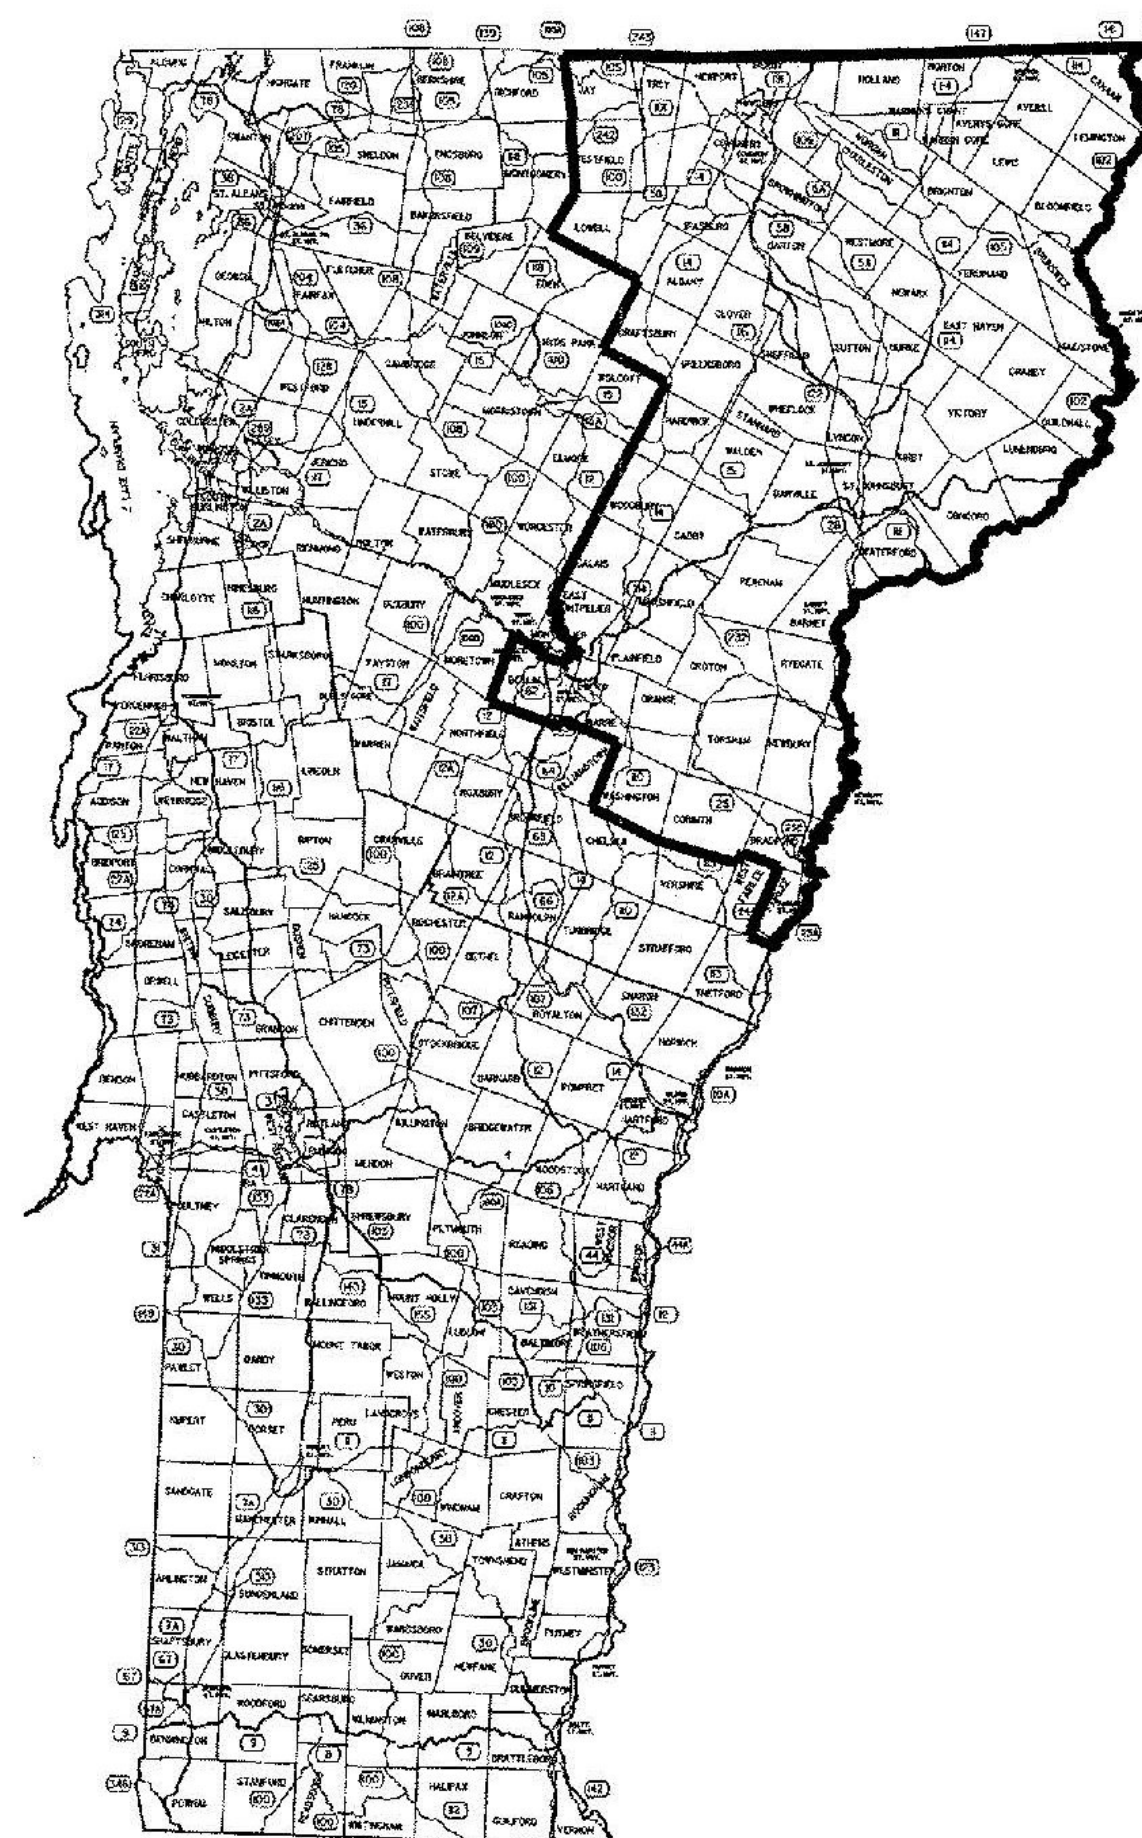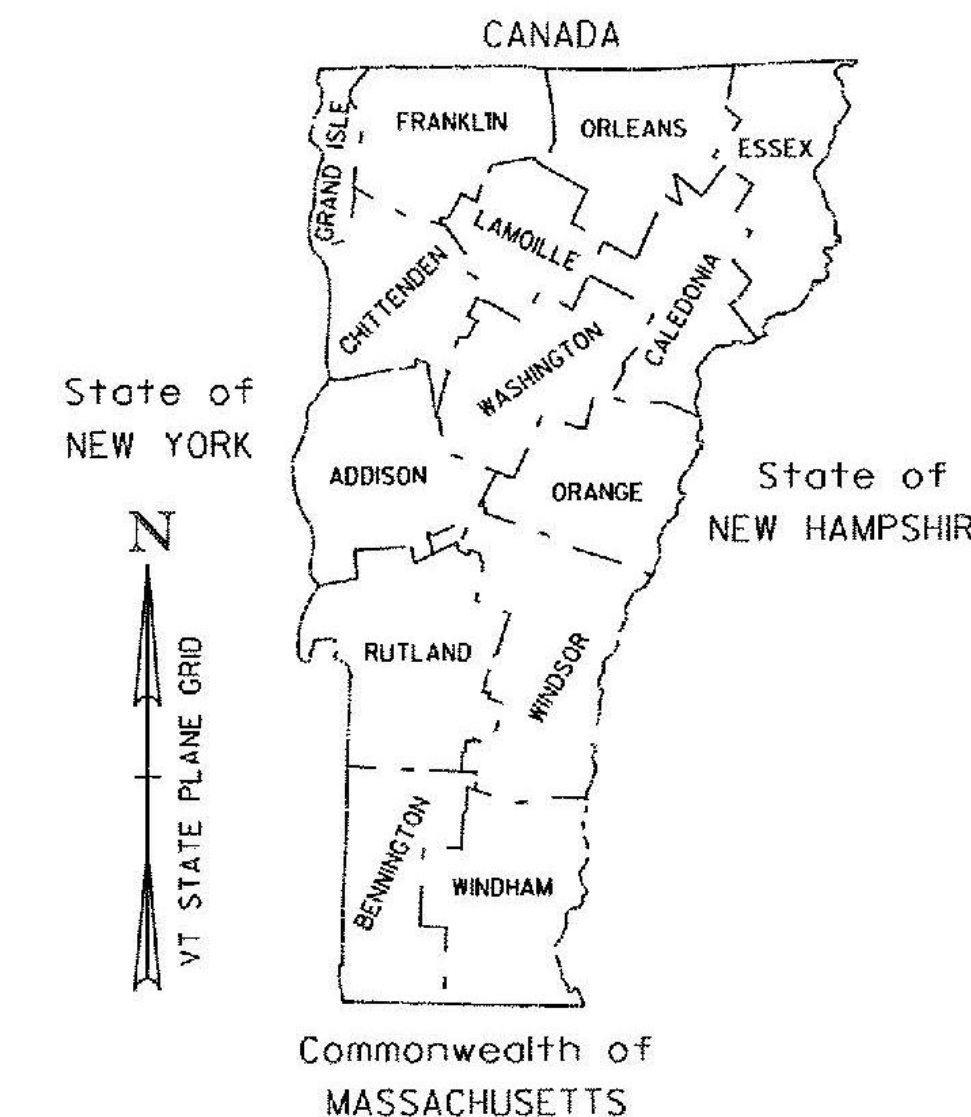


LENGTH OF PROJECT 1084.742 MI = 5,727,437.76 LF



CONSTRUCTION IS TO BE CARRIED ON IN ACCORDANCE WITH THESE PLANS AND THE STANDARD SPECIFICATIONS FOR CONSTRUCTION DATED 201 1, AS APPROVED BY THE FEDERAL HIGHWAY ADMINISTRATION ON JULY 20, 201 1 FOR USE ON THIS PROJECT, INCLUDING ALL SUBSEQUENT REVISIONS AND SUCH REVISED SPECIFICATIONS AND SPECIAL PROVISIONS AS ARE INCORPORATED IN THESE PLANS.

QUALITY ASSURANCE PROGRAM : LEVEL 1	
SURVEYED BY :	N/A
SURVEYED DATE :	N/A
DATUM	
VERTICAL	N/A
HORIZONTAL	N/A

BUILT AS DESIGNED

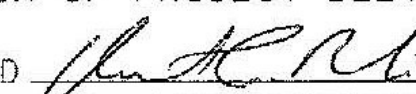 	DIRECTOR OF PROJECT DELIVERY APPROVED:  DATE: 2/6/2017
	PROJECT MANAGER : PATRICIA COBURN P.E. PROJECT NAME : STATEWIDE-NORTHEAST REGION PROJECT NUMBER : STPG MARK(306)
SHEET 1 OF 18 SHEETS	