

INDEX OF SHEETS

- 1 TITLE SHEET
- 2 QUANTITY SHEET
- 3 TRAFFIC CONTROL PLAN
- 4 MISCELLANEOUS DETAILS SHEET
- 5-7 ROAD QUANTITY SHEETS 1-3
- 8 ROAD SUMMARY SHEET
- 9-16 CLASS 2 TOWN HIGHWAY QUANTITIES SHEETS 1-8

VAOT STANDARDS

- E-192 10/12/2000
- E-193 08/18/1995
- T-1 04/25/2016
- T-11 08/06/2012
- T-12 08/06/2012
- T-22 08/06/2012
- T-23 08/06/2012
- T-24 08/06/2012
- T-28 08/06/2012
- T-29 08/06/2012
- T-31 08/06/2012


STATE OF VERMONT AGENCY OF TRANSPORTATION



PROPOSED IMPROVEMENT STATEWIDE - SOUTHEAST REGION NATIONAL HIGHWAY SYSTEM, STATE ROAD, CLASS 1 & CLASS 2 TOWN HIGHWAYS

APPLICATION OF CENTER LINE, EDGE LINE AND LANE LINE MARKINGS ON NATIONAL HIGHWAY AND STATE SYSTEM ROADS. APPLICATION OF CENTER LINE MARKINGS ONLY ON CLASS 1 AND CLASS 2 TOWN HIGHWAYS WITHIN ADDISON, ORANGE, WASHINGTON, WINDHAM, AND WINDSOR COUNTIES.

LENGTH OF PROJECT 1016.894 MI = 5,369,200.32 LF

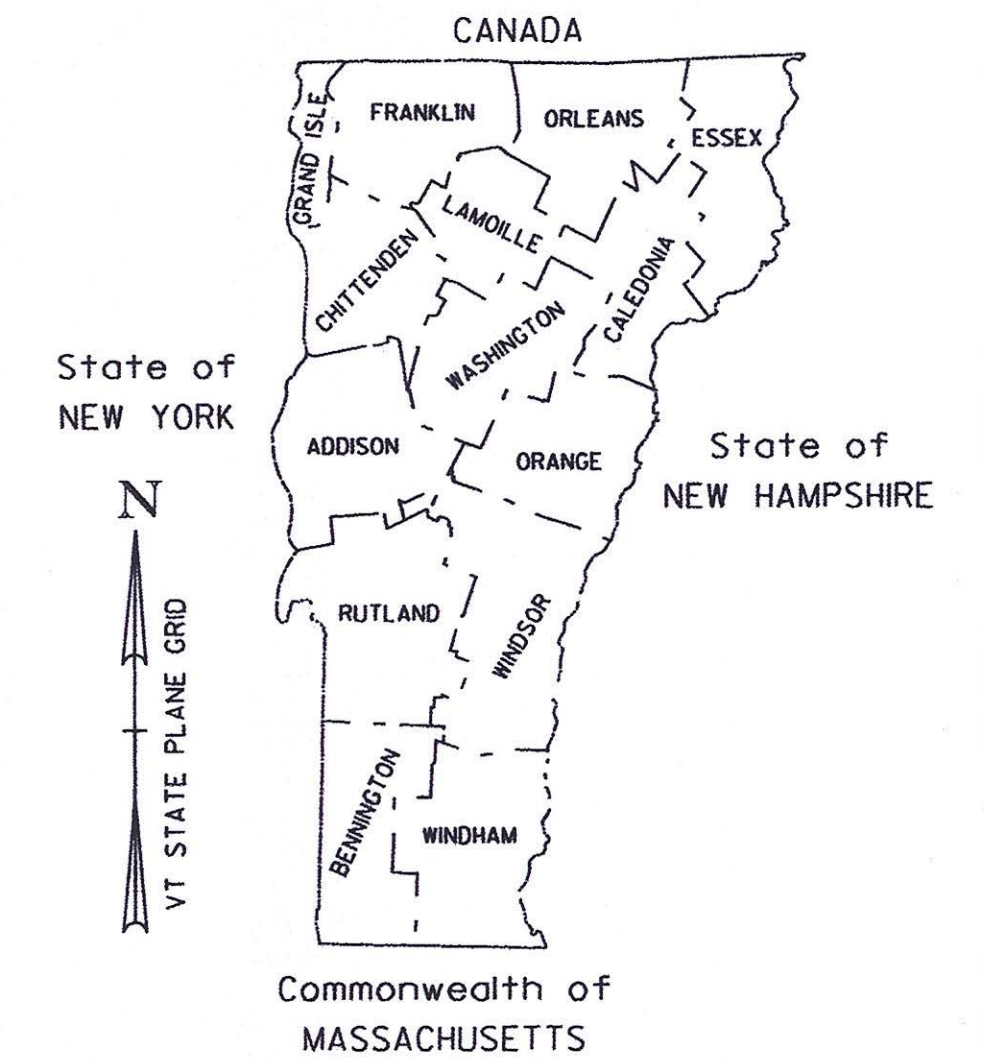


RECORD PLANS

CONTRACTOR: HI-WAY SAFETY SYSTEMS, INC. - ROCKLAND, MA
 RESIDENT ENGINEER: TOM CHASE
 CONSTRUCTION BEGAN: JUNE 08, 2017
 CONSTRUCTION COMPLETE: NOVEMBER 12, 2017
 RECORD PLANS BY: TOM CHASE & JESSE IVES


I HEREBY CERTIFY THAT ALL THE CONSTRUCTION REQUIRED BY THIS SET OF DRAWINGS HAS BEEN ACCOMPLISHED AS INDICATED HEREIN.

BY Thomas A. Chase RESIDENT ENGINEER
 DATE 01/30/18

NOTE: Any further information concerning final quantities, amounts or other details relative to this project may be found at Central Files in the electronic archives.

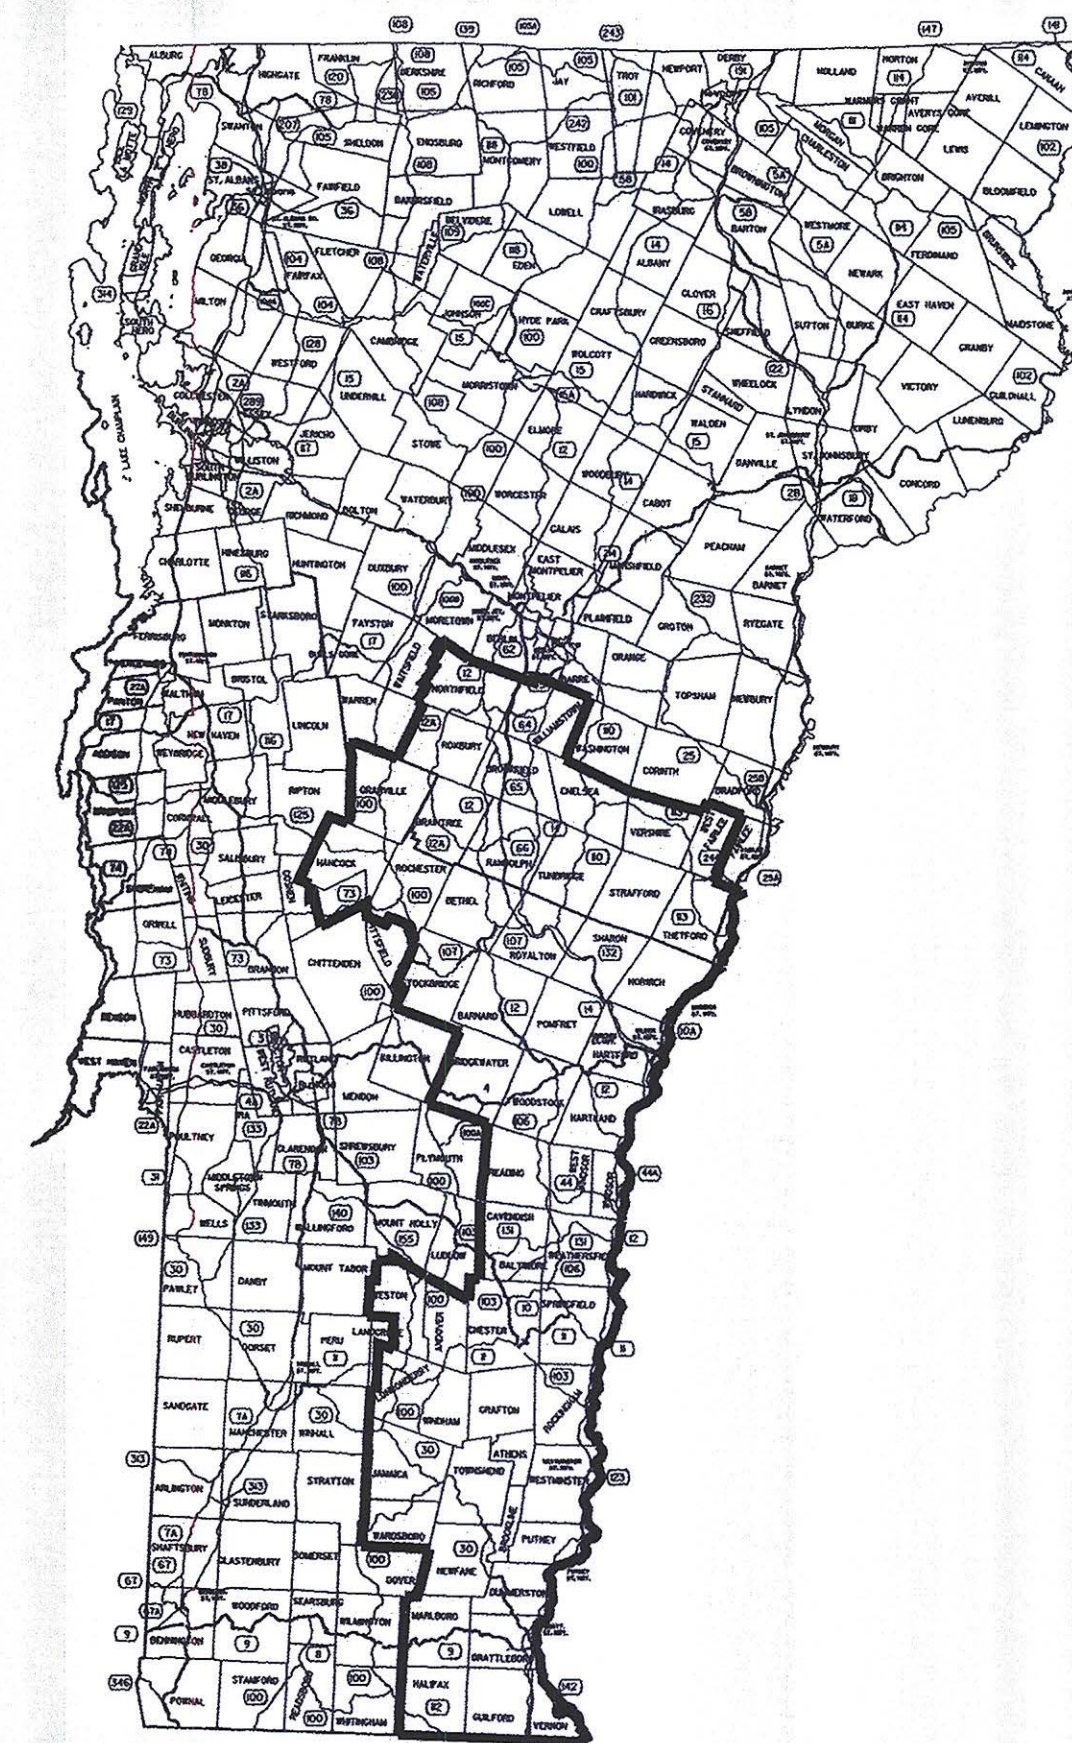

CONSTRUCTION IS TO BE CARRIED ON IN ACCORDANCE WITH THESE PLANS AND THE STANDARD SPECIFICATIONS FOR CONSTRUCTION DATED 201 1, AS APPROVED BY THE FEDERAL HIGHWAY ADMINISTRATION ON JULY 20, 201 1 FOR USE ON THIS PROJECT, INCLUDING ALL SUBSEQUENT REVISIONS AND SUCH REVISED SPECIFICATIONS AND SPECIAL PROVISIONS AS ARE INCORPORATED IN THESE PLANS.

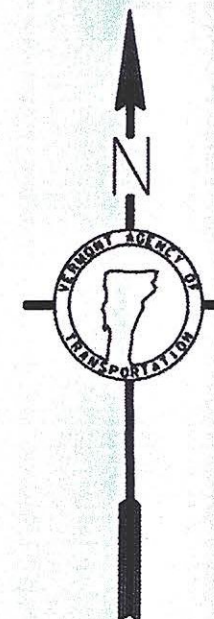

QUALITY ASSURANCE PROGRAM : LEVEL 1

SURVEYED BY : N/A
 SURVEYED DATE : N/A

DATUM
 VERTICAL N/A
 HORIZONTAL N/A

BUILT AS DESIGNED

		DIRECTOR OF PROJECT DELIVERY APPROVED <u>[Signature]</u> DATE <u>2/6/2017</u> PROJECT MANAGER : PATRICIA COBURN P.E.
	PROJECT NAME : STATEWIDE-SOUTHEAST REGION PROJECT NUMBER : STPG MARK(308) SHEET 1 OF 16 SHEETS	