

**INDEX OF SHEETS**

- 1 TITLE SHEET
- 2 QUANTITY SHEET
- 3 TRAFFIC CONTROL PLAN
- 4 MISCELLANEOUS DETAILS SHEET
- 5-7 ROAD QUANTITY SHEETS 1-3
- 8 ROAD SUMMARY SHEET
- 9-16 CLASS 2 TOWN HIGHWAY QUANTITIES SHEETS 1-8

**VAOT STANDARDS**

- E-192 10/12/2000
- E-193 08/18/1995
- T-1 04/25/2016
- T-11 08/06/2012
- T-12 08/06/2012
- T-22 08/06/2012
- T-23 08/06/2012
- T-24 08/06/2012
- T-28 08/06/2012
- T-29 08/06/2012
- T-31 08/06/2012


# STATE OF VERMONT AGENCY OF TRANSPORTATION



## PROPOSED IMPROVEMENT STATEWIDE - SOUTHEAST REGION NATIONAL HIGHWAY SYSTEM, STATE ROAD, CLASS 1 & CLASS 2 TOWN HIGHWAYS

APPLICATION OF CENTER LINE, EDGE LINE AND LANE LINE MARKINGS ON NATIONAL HIGHWAY AND STATE SYSTEM ROADS. APPLICATION OF CENTER LINE MARKINGS ONLY ON CLASS 1 AND CLASS 2 TOWN HIGHWAYS WITHIN ADDISON, ORANGE, WASHINGTON, WINDHAM, AND WINDSOR COUNTIES.

LENGTH OF PROJECT 1016.894 MI = 5,369,200.32 LF

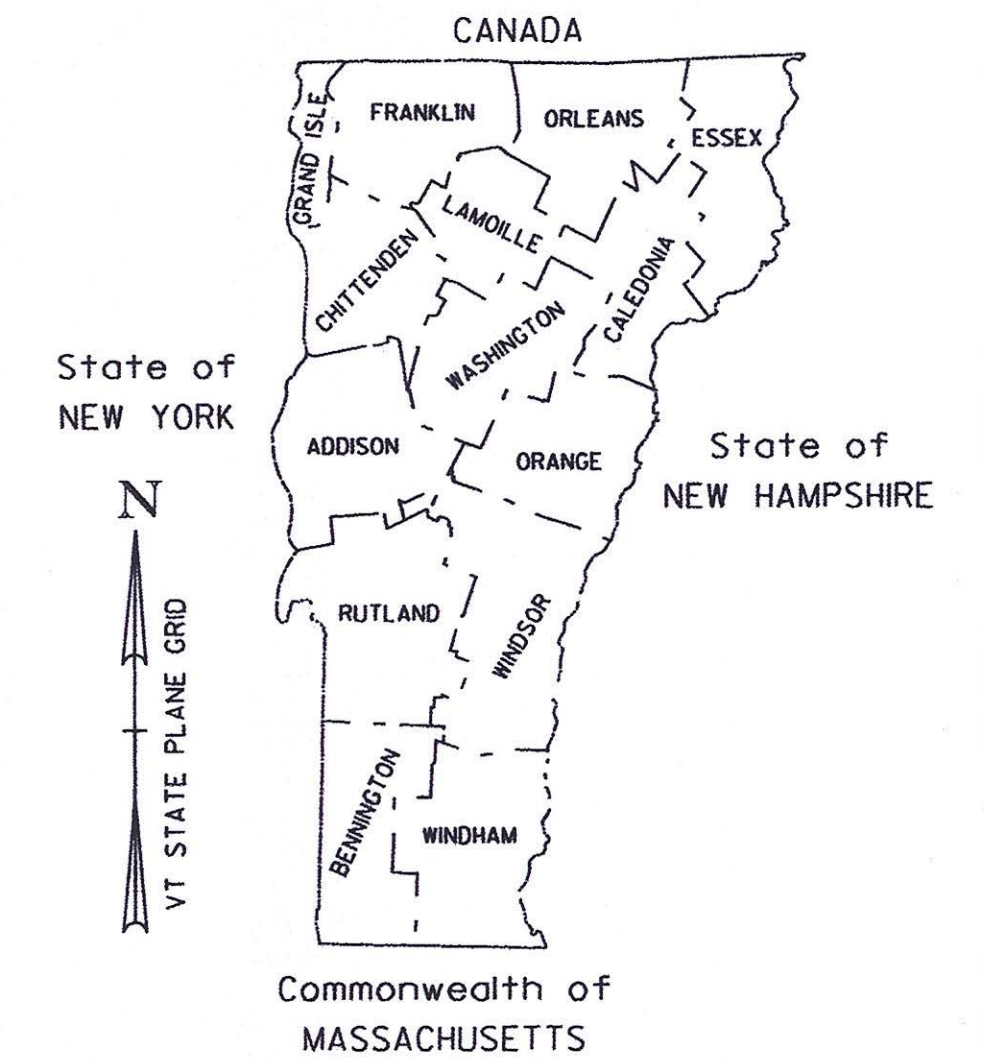


**RECORD PLANS**

CONTRACTOR: HI-WAY SAFETY SYSTEMS, INC. - ROCKLAND, MA  
 RESIDENT ENGINEER: TOM CHASE  
 CONSTRUCTION BEGAN: JUNE 08, 2017  
 CONSTRUCTION COMPLETE: NOVEMBER 12, 2017  
 RECORD PLANS BY: TOM CHASE & JESSE IVES


I HEREBY CERTIFY THAT ALL THE CONSTRUCTION REQUIRED BY THIS SET OF DRAWINGS HAS BEEN ACCOMPLISHED AS INDICATED HEREIN.

BY Thomas A. Chase RESIDENT ENGINEER  
 DATE 01/30/18

NOTE: Any further information concerning final quantities, amounts or other details relative to this project may be found at Central Files in the electronic archives.

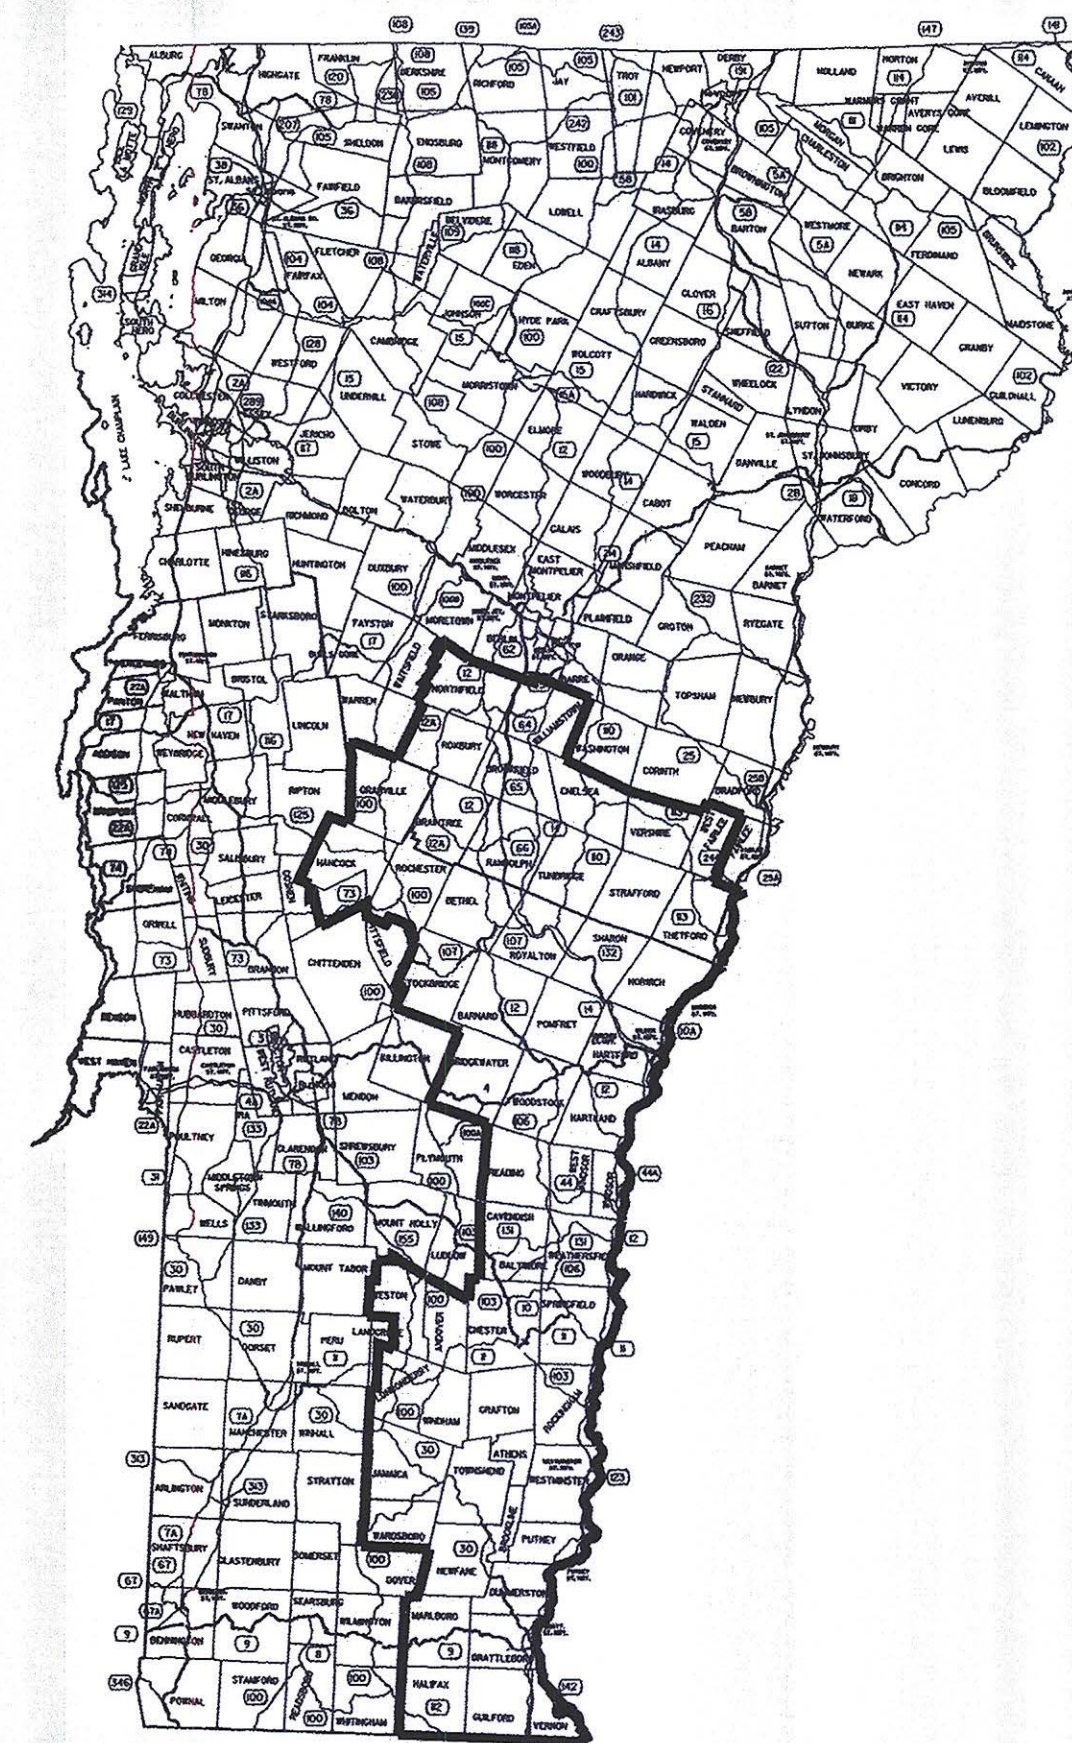

CONSTRUCTION IS TO BE CARRIED ON IN ACCORDANCE WITH THESE PLANS AND THE STANDARD SPECIFICATIONS FOR CONSTRUCTION DATED 201 1, AS APPROVED BY THE FEDERAL HIGHWAY ADMINISTRATION ON JULY 20, 201 1 FOR USE ON THIS PROJECT, INCLUDING ALL SUBSEQUENT REVISIONS AND SUCH REVISED SPECIFICATIONS AND SPECIAL PROVISIONS AS ARE INCORPORATED IN THESE PLANS.

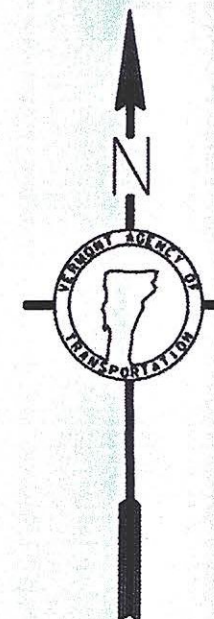

QUALITY ASSURANCE PROGRAM : LEVEL 1	
SURVEYED BY :	N/A
SURVEYED DATE :	N/A
DATUM	
VERTICAL	N/A
HORIZONTAL	N/A

**BUILT AS DESIGNED**


		DIRECTOR OF PROJECT DELIVERY
	APPROVED <u>[Signature]</u> DATE <u>2/6/2017</u>	PROJECT MANAGER : PATRICIA COBURN P.E.
	PROJECT NAME : STATEWIDE-SOUTHEAST REGION	PROJECT NUMBER : STPG MARK(308)
	SHEET 1 OF 16 SHEETS	

# QUANTITY SHEET 1

SUMMARY OF ESTIMATED QUANTITIES										TOTALS		DESCRIPTIONS				DETAILED SUMMARY OF QUANTITIES		
									ROADWAY	GRAND TOTAL	FINAL	UNIT	ITEMS	ITEM NUMBER	ROUND	QUANTITIES	UNIT	ITEMS
									1100	1100		HR	TRUCK-MOUNTED ATTENUATOR, AWW/PV	608.50	EST.			
									425	425		HR	UNIFORMED TRAFFIC OFFICERS	630.10	EST.			
									1	1		LS	MOBILIZATION/DEMOBILIZATION	635.11	--			
									1	1		LS	TRAFFIC CONTROL	641.10	--			
									5250000	5250000		LF	4 INCH WHITE LINE, WATERBORNE PAINT	646.201	EST.			
									9350000	9350000		LF	4 INCH YELLOW LINE, WATERBORNE PAINT	646.2111	EST.			ITEM 646.2111 (4 INCH YELLOW LINE, WATERBORNE PAINT)
									5000	5000		LF	6 INCH WHITE LINE, WATERBORNE PAINT	646.2141	EST.	4625037	LF	FOR STATE HIGHWAYS AND CLASS 1 ROADS
									5000	5000		LF	6 INCH YELLOW LINE, WATERBORNE PAINT	646.2151	EST.	4693286	LF	FOR CLASS 2 ROADS
									450	450		LF	8 INCH WHITE LINE, WATERBORNE PAINT	646.221	EST.	31677	LF	ROUNDING
									5800	5800		LF	12 INCH WHITE LINE, WATERBORNE PAINT	646.241	EST.	9350000	LF	TOTAL

PROJECT NAME:	STATEWIDE SOUTHEAST REGION
PROJECT NUMBER:	STPG MARK(308)
FILE NAME: z16+087frrm.dgn	PLOT DATE: 2/9/2017
PROJECT LEADER: C. LATHROP	DRAWN BY: P. DAY
DESIGNED BY: P. DAY	CHECKED BY: C. LATHROP
QUANTITY SHEET	SHEET 2 OF 16

# TRAFFIC CONTROL PLAN

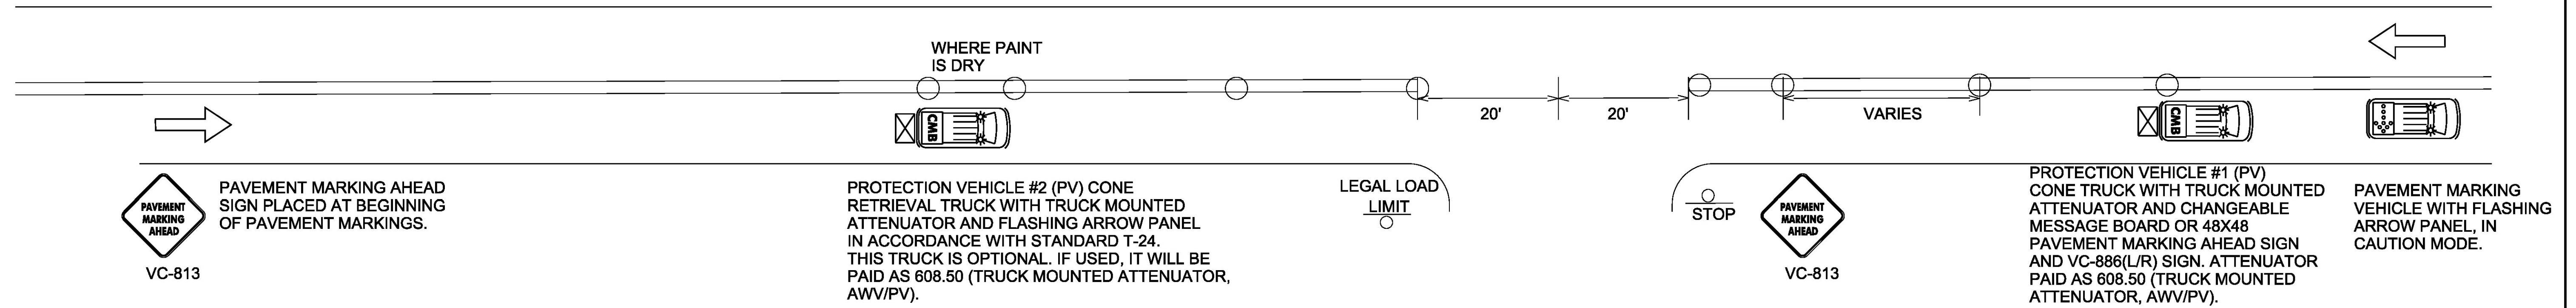

**NOTES**






1. ALL WORK VEHICLES USED SHALL DISPLAY HIGH-INTENSITY ROTATING, FLASHING, OSCILLATING OR STROBE LIGHTS.
2. ALL PROTECTION VEHICLES SHALL BE EQUIPPED WITH A TRUCK MOUNTED ATTENUATOR WITH A VC-866(L/R) SIGN IN ACCORDANCE WITH STANDARD T-29 ATTACHED AND A FLASHING ARROW PANEL IN ACCORDANCE WITH STANDARD T-24. PAYMENT WILL BE MADE UNDER ITEM 608.50 (TRUCK MOUNTED ATTENUATOR, AWW/PV).
3. FLASHING ARROW PANELS MOUNTED TO VEHICLES WILL NOT BE PAID FOR DIRECTLY, BUT WILL BE CONSIDERED INCIDENTAL TO ITEM 641.10 (TRAFFIC CONTROL). FLASHING ARROW PANELS SHALL BE USED IN CAUTION MODE WHEN VEHICLE IS IN TRAVEL LANE.
4. PROTECTION VEHICLE #1 SHALL TRAVEL AT A VARYING DISTANCE FROM PAVEMENT MARKING VEHICLE WHILE SETTING CONES ON THE WET PAINT TO ENSURE ADEQUATE SIGHT DISTANCE FOR TRAFFIC APPROACHING FROM THE REAR.
5. UNIFORMED TRAFFIC OFFICER (UTO) REQUIRED FOR NIGHT WORK, AND AT OTHER TIMES AS DIRECTED BY THE ENGINEER. UNIFORMED TRAFFIC OFFICERS WILL BE PAID UNDER ITEM 630.10 (UNIFORMED TRAFFIC OFFICER).
6. THE NUMBER OF CHANNELIZING DEVICES AND OTHER TRAFFIC CONTROL DEVICES SHOWN ON THIS SHEET ARE FOR ILLUSTRATIVE PURPOSES ONLY. THE ACTUAL NUMBER REQUIRED IS TO BE DETERMINED BY THE CONTRACTOR IN ACCORDANCE WITH THE MUTCD AND STANDARD T-24 BASED ON FIELD CONDITIONS OR AS DIRECTED BY THE ENGINEER.
7. CONE VEHICLES SHALL HAVE PROTECTIVE CAGES TO PROTECT THE PERSON PLACING AND RETRIEVING CONES.
8. PAVEMENT MARKING AHEAD SIGNS IN ACCORDANCE WITH STANDARD T-28 SHALL BE PLACED AT THE BEGINNING OF PAVEMENT MARKING OPERATION AND AT A MINIMUM OF EVERY 3 MILES. THEY SHALL ALSO BE PLACED AFTER EVERY NUMBERED STATE HIGHWAY OR MAJOR INTERSECTION INCLUDING COMMERCIAL DRIVES.
9. WORK VEHICLES SHALL PULL OVER TO ALLOW VEHICLES TO PASS AT REASONABLE INTERVALS TO AVOID EXCESSIVE QUEUING AND DELAYS.
10. CONE PICK-UP MAY BE ACCOMPLISHED USING DEDICATED VEHICLE (PV#2) OR BY PROTECTION VEHICLE #1 WHEN PAINT TRUCK IS NOT OPERATING AND PAINT IS DRY. QUANTITY OF 608.50 (TRUCK MOUNTED ATTENUATOR, AWW/PV) SHALL BE MEASURED AS THE NUMBER OF VEHICLE HOURS USED.
11. CONES SHALL BE LEFT IN PLACE UNTIL PAINT IS DRY AND NOT TRACKING.
12. ALL TRAFFIC CONTROL ITEMS WILL BE PAID UNDER PAY ITEM 641.10 UNLESS OTHERWISE SPECIFIED.

**LEGEND**

- INDICATES TRAFFIC FLOW
- FLASHING ARROW PANEL
- TRUCK MOUNTED ATTENUATOR
- CHANGEABLE MESSAGE BOARD
- 28" RETROREFLECTORIZED CONE
- MARKING OPERATIONS VEHICLE

PROJECT NAME:	STATEWIDE SOUTHEAST REGION
PROJECT NUMBER:	STPG MARK(308)
FILE NAME: z16+087frrm.dgn	PLOT DATE: 2/9/2017
PROJECT LEADER: C. LATHROP	DRAWN BY: P. DAY
DESIGNED BY: P. DAY	CHECKED BY: C. LATHROP
TRAFFIC CONTROL PLAN	SHEET 3 OF 16


NOT TO SCALE

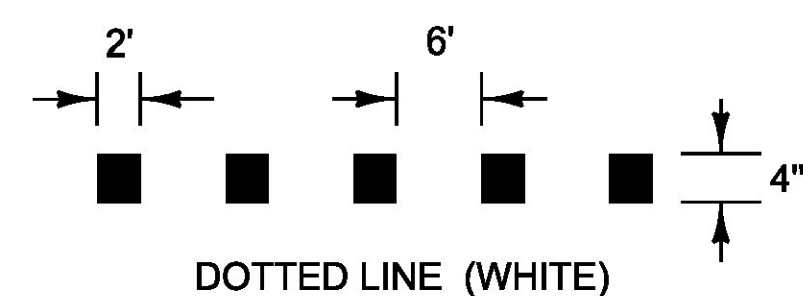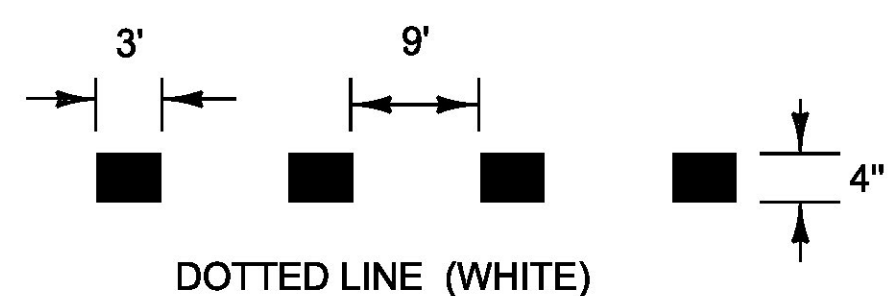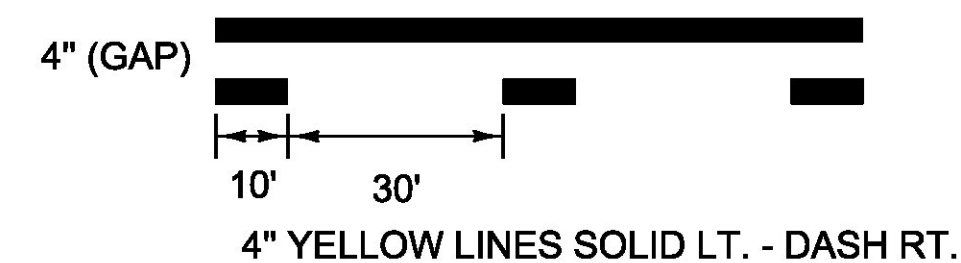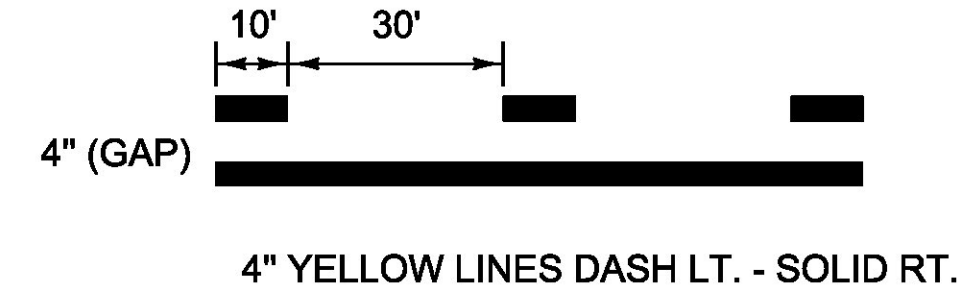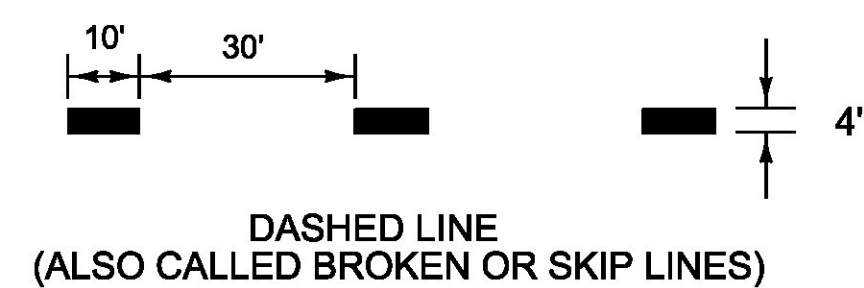

PAVEMENT MARKING LINE DETAILS

NOTES:

1. ALL MARKINGS SHALL BE APPLIED TO MATCH EXISTING OR AS DIRECTED BY THE ENGINEER.
2. IN AREAS THAT HAVE 6 INCH MARKINGS THERE SHALL BE A 6 INCH GAP BETWEEN LINES WITH A 6 INCH LINE WIDTH. MARKINGS SHOULD MATCH EXISTING.

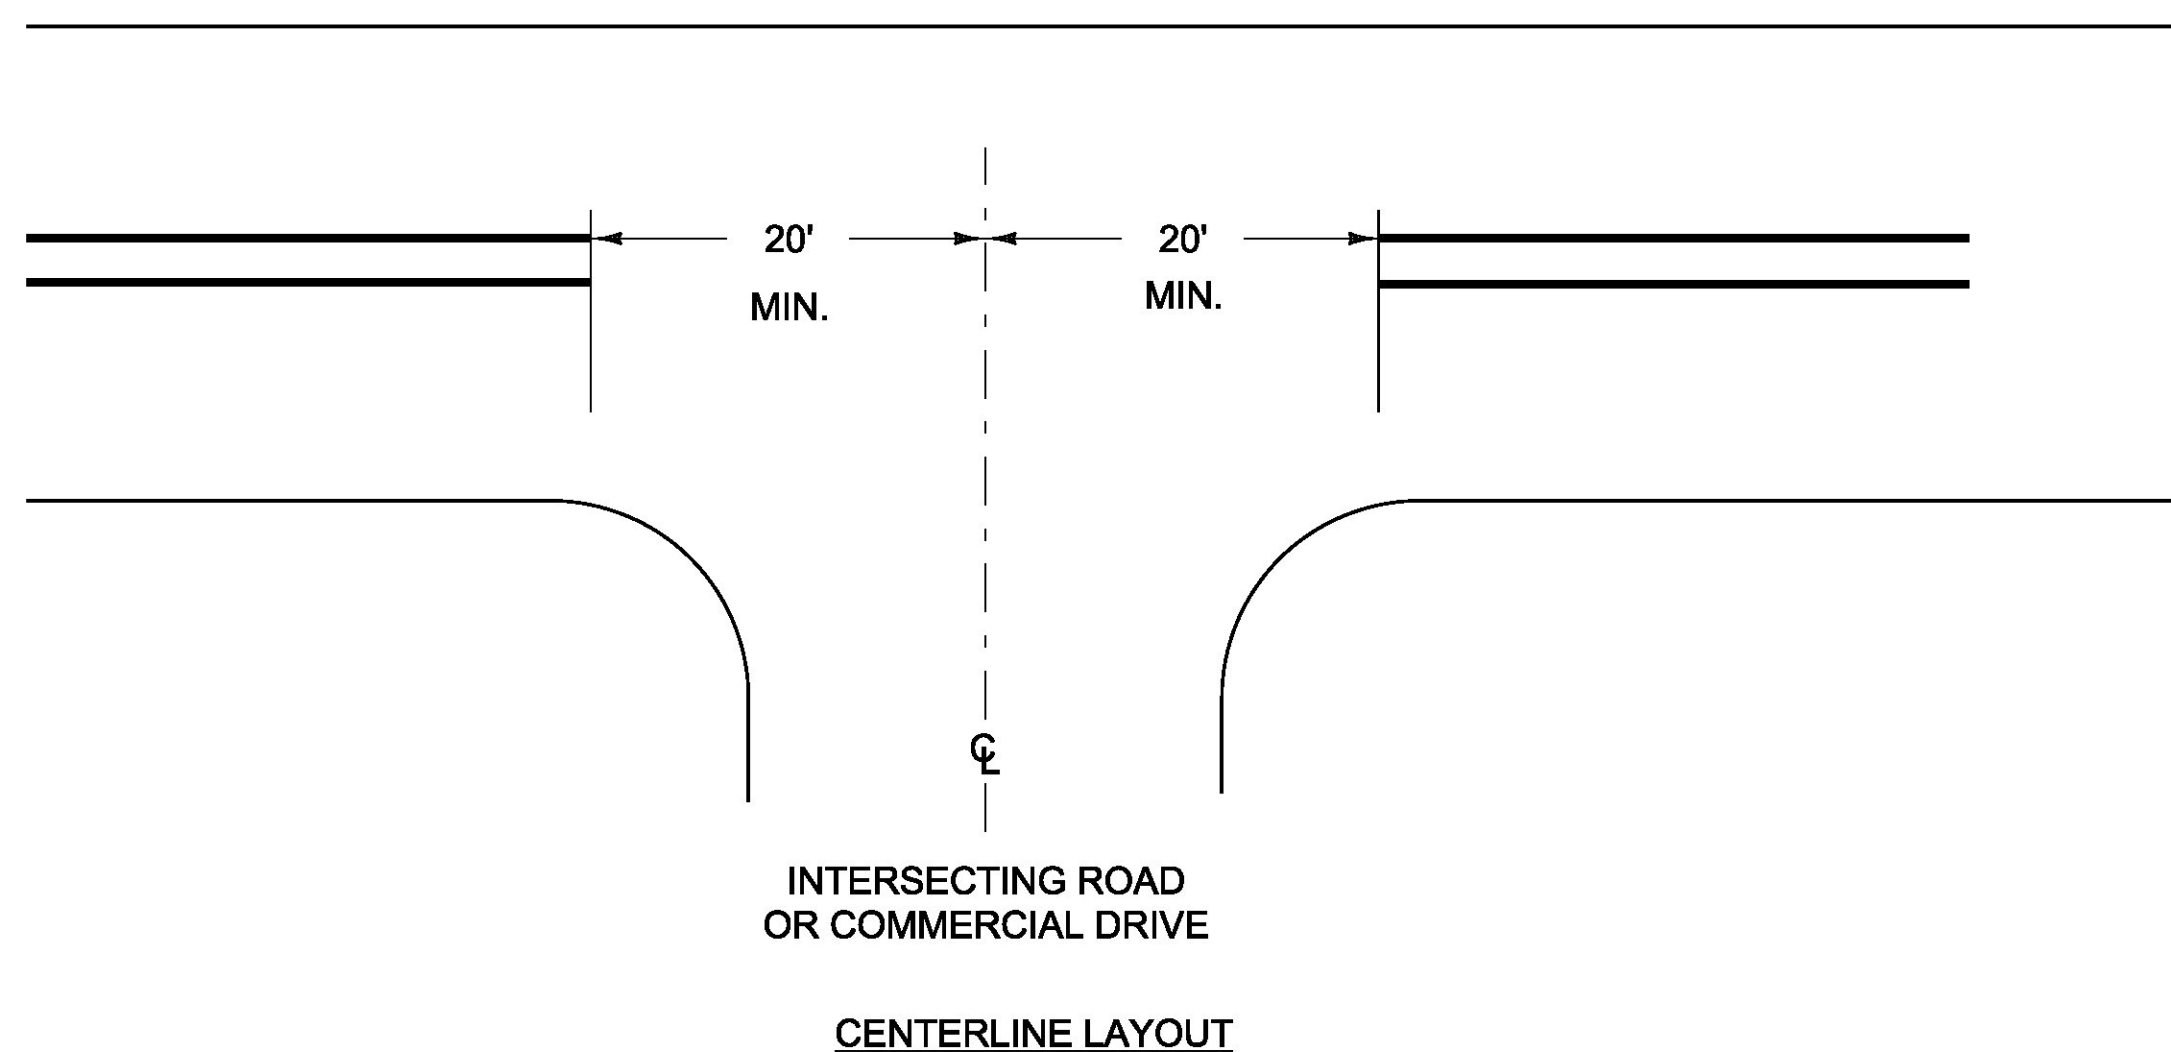


CENTERLINE BREAKS:

1. AT ALL STATE HIGHWAYS, TOWN HIGHWAYS THAT HAVE STOP OR YIELD SIGNS INSTALLED.
2. COMMERCIAL DRIVES:
  - A. WHERE A SEPARATE TURN LANE EXISTS ON THE MAIN LINE (LT. OR RT.).
  - B. WHERE SIGNIFICANT TRAFFIC VOLUMES EXIST.

GENERAL NOTES:

1. STATE HIGHWAY SYSTEM ROADS SHALL BE MARKED WITH YELLOW CENTERLINE AND WHITE EDGE LINE AND LANE LINES TO MATCH EXISTING. CLASS 1 AND CLASS 2 TOWN HIGHWAYS SHALL BE MARKED WITH YELLOW CENTERLINE ONLY.
2. ROADS THAT ARE SCHEDULED FOR REPAIR OR ARE PART OF AN ACTIVE CONSTRUCTION PROJECT SHALL BE EXCLUDED AT THE DIRECTION OF THE ENGINEER. ANY MARKINGS DEEMED BY THE ENGINEER TO NOT REQUIRE REPAINTING SHALL BE EXCLUDED FROM THE PROJECT. ESTIMATED QUANTITIES ASSUME 10% OF THE SYSTEM WILL BE EXCLUDED FROM CONTRACT WORK.
3. ESTIMATED QUANTITIES FOR ALL OTHER MARKING ITEMS WERE BASED ON FACTORS DETERMINED FROM PREVIOUS PROJECTS. THE TOTAL QUANTITY MEASURED FOR PAYMENT WILL BE THE ACTUAL QUANTITY MARKED AS DIRECTED BY THE ENGINEER.
4. THE CONTRACTOR SHALL COORDINATE WITH VTRANS TO SCHEDULE MARKING ON ALL ROADS THAT ARE SCHEDULED FOR REPAIRS OR RETREATMENT.
5. LANES TO BE PAINTED ON BOTH SIDES SHALL BE MARKED IN MULTIPLE PASSES SUCH THAT TRAFFIC DOES NOT TRAVEL BETWEEN WET PAINT AT ANY TIME. PAINT SHALL BE ALLOWED TO FULLY DRY BEFORE ANY SUBSEQUENT MARKINGS ARE APPLIED.
6. TOWN HIGHWAY MAPS ARE AVAILABLE FOR REFERENCE IF NEEDED FROM THE VTRANS WEBSITE.
7. MARKINGS SHALL MATCH EXISTING, OR AS DIRECTED BY THE ENGINEER. THE PLANS INDICATE 6 INCH MARKINGS BASED ON BEST AVAILABLE INFORMATION. ROUNDABOUTS AND OTHER LOCATIONS MAY ALSO HAVE 6 INCH MARKINGS AND SHALL BE MARKED TO MATCH EXISTING. PAYMENT WILL BE FOR THE ACTUAL QUANTITY APPLIED OF EACH MARKING AS DIRECTED BY THE ENGINEER.
8. LONGITUDINAL 8 INCH AND 12 INCH WHITE AND YELLOW LINES, EXCLUDING DIAGONAL GORE MARKINGS, SHALL BE MARKED AND MATCH EXISTING, OR AS DIRECTED BY THE ENGINEER.
9. SIDE ROAD RADII SHALL BE MARKED IN ACCORDANCE WITH STD. E-193.
10. ROUTES NOTED AS NIGHT WORK IN THE PLANS ARE REQUIRED TO BE MARKED AT NIGHT. THE CONTRACTOR MAY PROPOSE OTHER ROUTES TO BE MARKED AT NIGHT SUBJECT TO APPROVAL BY THE ENGINEER. A UNIFORMED TRAFFIC OFFICER WITH BLUE LIGHT SHALL BE REQUIRED FOR ALL NIGHT WORK.
11. ROUTES LABELED NHS OR BIKE LANES IN THE PLANS SHALL BE COMPLETED BY THE INTERIM COMPLETION DATE PER THE CONTRACT DOCUMENTS. THESE NOTES SHOULD NOT BE USED TO DETERMINE THE INCLUSION OF ANY ROAD ON THE NATIONAL HIGHWAY SYSTEM FOR ANY OTHER PURPOSE.

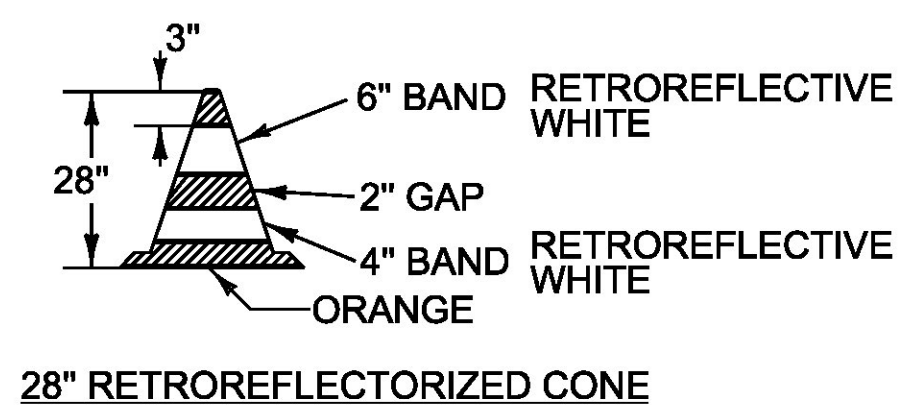

NOTES:

1. 28" RETROREFLECTORIZED CONES SHALL BE USED ON ALL ROADWAYS.
2. CONES MAY BE WEIGHTED TO PREVENT OVER-TURNING, HOWEVER THE WEIGHTS SHALL NOT PRESENT A HAZARD IF THE CONE IS STRUCK.

NOT TO SCALE

PROJECT NAME:	STATEWIDE SOUTHEAST REGION
PROJECT NUMBER:	STPG MARK(308)
FILE NAME: z16+087frrm.dgn	PLOT DATE: 2/9/2017
PROJECT LEADER: C. LATHROP	DRAWN BY: P. DAY
DESIGNED BY: P. DAY	CHECKED BY: C. LATHROP
MISCELLANEOUS DETAILS SHEET	SHEET 4 OF 16

SUMMARY BY ROUTE OF STATE HIGHWAYS AND CLASS 1 TOWN HIGHWAYS

COUNTY	TOWN NAME	ROUTE NAME	HIGHWAY SIGN	MILEAGE	LINEAR FEET	COMMENTS
WINDHAM COUNTY	BRATTLEBORO	NSH-BSH	BRATTLEBORO STATE HIGHWAY	0.135	712.80	BEGINS AT EXIT 3 AND ENDS AT ROUDABOUT. DIVIDED
WINDHAM COUNTY	BRATTLEBORO	NSH-BSH	BRATTLEBORO STATE HIGHWAY	0.135	712.80	
		<b>NSH-BSH TOTAL</b>		<b>0.270</b>	<b>1425.60</b>	
WINDSOR COUNTY	NORWICH	NSH-NSH	NORWICH STATE HIGHWAY	1.150	6072.00	BEGINS AT VT 10A AND ENDS AT US 5
WINDSOR COUNTY	NORWICH	NSH-NSH	NORWICH STATE HIGHWAY	0.018	95.04	
		<b>NSH-NSH TOTAL</b>		<b>1.168</b>	<b>6167.04</b>	
WINDHAM COUNTY	PUTNEY	NSH-PSH	PUTNEY STATE HIGHWAY	0.289	1525.92	BEGINS AT INTERSTATE AND ENDS AT US 5
WINDHAM COUNTY	PUTNEY	NSH-PSH	PUTNEY STATE HIGHWAY	0.073	385.44	
		<b>NSH-PSH TOTAL</b>		<b>0.362</b>	<b>1911.36</b>	
WINDSOR COUNTY	HARTFORD	NSH-QSH	QUECHEE STATE HIGHWAY	0.123	649.44	BEGINS AT EXIT 1 RAMP AND ENDS AT US 4. DIVIDED
WINDSOR COUNTY	HARTFORD	NSH-QSH	QUECHEE STATE HIGHWAY	0.123	649.44	
		<b>NSH-QSH TOTAL</b>		<b>0.246</b>	<b>1298.88</b>	
WINDHAM COUNTY	WESTMINSTER	NSH-WMSH	WESTMINSTER STATE HIGHWAY	0.770	4065.60	BEGINS AT INTERSTATE AND ENDS AT US 5
WINDHAM COUNTY	WESTMINSTER	NSH-WMSH	WESTMINSTER STATE HIGHWAY	0.145	765.60	
		<b>NSH-WMSH TOTAL</b>		<b>0.915</b>	<b>4831.20</b>	
WINDSOR COUNTY	HARTFORD	NSH-WSH	WILDER STATE HIGHWAY	0.744	3928.32	BEGINS AT EXIT 12 AND ENDS AT CHRISTIAN ST
		<b>NSH-WSH TOTAL</b>		<b>0.744</b>	<b>3928.32</b>	
WINDSOR COUNTY	BRIDGEWATER	US-4	US-4	7.513	39668.64	NHS
WINDSOR COUNTY	WOODSTOCK	US-4	US-4	8.333	43998.24	NHS
WINDSOR COUNTY	WOODSTOCK	TH-1	US-4	1.135	5992.80	NHS
WINDSOR COUNTY	WOODSTOCK	TH-1	US-4	0.180	950.40	NHS, DIVIDED
WINDSOR COUNTY	WOODSTOCK	TH-2	US-4	0.180	950.40	
WINDSOR COUNTY	HARTLAND	US-4	US-4	0.773	4081.44	NHS
WINDSOR COUNTY	HARTFORD	TH-1	US-4	0.237	1251.36	NHS
WINDSOR COUNTY	HARTFORD	US-4	US-4	2.735	14440.80	NHS
WINDSOR COUNTY	HARTFORD	US-4	US-4	6.427	33934.56	NHS
WINDSOR COUNTY	HARTFORD	US-4	US-4	0.108	570.24	NHS, DIVIDED
WINDSOR COUNTY	HARTFORD	US-4	US-4	0.108	570.24	
WINDSOR COUNTY	HARTFORD	US-4	US-4	0.084	443.52	NHS, DIVIDED
WINDSOR COUNTY	HARTFORD	US-4	US-4	0.084	443.52	
WINDSOR COUNTY	HARTFORD	US-4	US-4	0.097	512.16	NHS, RAMP
		<b>US-4 TOTAL</b>		<b>27.994</b>	<b>147808.32</b>	

COUNTY	TOWN NAME	ROUTE NAME	HIGHWAY SIGN	MILEAGE	LINEAR FEET	COMMENTS
WINDHAM COUNTY	GUILFORD	US-5	US-5	6.758	35682.24	
WINDHAM COUNTY	VERNON	US-5	US-5	0.218	1151.04	
WINDHAM COUNTY	BRATTLEBORO	TH-1	US-5	1.736	9166.08	
WINDHAM COUNTY	BRATTLEBORO	TH-1	US-5	0.162	855.36	
WINDHAM COUNTY	BRATTLEBORO	US-5	US-5	0.332	1752.96	
WINDHAM COUNTY	BRATTLEBORO	US-5	US-5	0.037	195.36	NHS, ROUNDABOUT
WINDHAM COUNTY	BRATTLEBORO	US-5	US-5	0.037	195.36	
WINDHAM COUNTY	BRATTLEBORO	US-5	US-5	3.230	17054.40	BIKE LANES
WINDHAM COUNTY	BRATTLEBORO	TH-1	US-5	0.270	1425.60	
WINDHAM COUNTY	BRATTLEBORO	TH-1	US-5	0.020	105.60	
WINDHAM COUNTY	BRATTLEBORO	TH-1	US-5	0.020	105.60	DIVIDED ISLAND RAMP
WINDHAM COUNTY	BRATTLEBORO	TH-1	US-5	0.025	132.00	
WINDHAM COUNTY	BRATTLEBORO	TH-1	US-5	0.150	792.00	
WINDHAM COUNTY	DUMMERSTON	US-5	US-5	5.287	27915.36	
WINDHAM COUNTY	PUTNEY	US-5	US-5	5.585	29488.80	
WINDHAM COUNTY	WESTMINSTER	US-5	US-5	8.215	43375.20	
WINDHAM COUNTY	ROCKINGHAM	TH-1	US-5	1.493	7883.04	
WINDHAM COUNTY	ROCKINGHAM	US-5	US-5	6.789	35845.92	
WINDHAM COUNTY	ROCKINGHAM	US-5	US-5	0.572	3020.16	NHS
WINDSOR COUNTY	SPRINGFIELD	US-5	US-5	8.758	46242.24	
WINDSOR COUNTY	SPRINGFIELD	US-5	US-5	0.360	1900.80	DIVIDED
WINDSOR COUNTY	SPRINGFIELD	US-5	US-5	0.346	1826.88	
WINDSOR COUNTY	WEATHERSFIELD	US-5	US-5	6.721	35486.88	
WINDSOR COUNTY	WEATHERSFIELD	US-5	US-5	0.070	369.60	DIVIDED
WINDSOR COUNTY	WEATHERSFIELD	US-5	US-5	0.070	369.60	
WINDSOR COUNTY	WINDSOR	TH-1	US-5	0.800	4224.00	
WINDSOR COUNTY	WINDSOR	US-5	US-5	6.045	31917.60	
WINDSOR COUNTY	HARTLAND	US-5	US-5	7.672	40508.16	
WINDSOR COUNTY	HARTFORD	US-5	US-5	1.065	5623.20	NHS
WINDSOR COUNTY	HARTFORD	US-5	US-5	5.664	29905.92	
WINDSOR COUNTY	HARTFORD	US-5	US-5	0.821	4334.88	
WINDSOR COUNTY	HARTFORD	US-5	US-5	1.065	5623.20	NHS
WINDSOR COUNTY	HARTFORD	US-5	US-5	0.821	4334.88	
WINDSOR COUNTY	NORWICH	US-5	US-5	0.022	116.16	NHS
WINDSOR COUNTY	NORWICH	US-5	US-5	8.042	42461.76	
WINDSOR COUNTY	NORWICH	US-5	US-5	0.226	1193.28	
WINDSOR COUNTY	NORWICH	US-5	US-5	0.242	1277.76	DIVIDED
ORANGE COUNTY	THETFORD	US-5	US-5	7.680	40550.40	
		<b>US-5 TOTAL</b>		<b>97.426</b>	<b>514409.28</b>	
WINDHAM COUNTY	MARLBORO	VT-9	VT-9	8.304	43845.12	NHS
WINDHAM COUNTY	BRATTLEBORO	TH-2	VT-9	1.066	5628.48	NHS
WINDHAM COUNTY	BRATTLEBORO	TH-2	VT-9	1.726	9113.28	NHS
WINDHAM COUNTY	BRATTLEBORO	VT-9	VT-9	4.295	22677.60	NHS, ROUNDABOUT
WINDHAM COUNTY	BRATTLEBORO	VT-9	VT-9	0.117	617.76	
WINDHAM COUNTY	BRATTLEBORO	VT-9	VT-9	0.113	596.64	NHS, DIVIDED
		<b>VT-9 TOTAL</b>		<b>15.621</b>	<b>82478.88</b>	
WINDSOR COUNTY	CHESTER	VT-10	VT-10	3.540	18691.20	
WINDSOR COUNTY	SPRINGFIELD	VT-10	VT-10	0.833	4398.24	
		<b>VT-10 TOTAL</b>		<b>4.373</b>	<b>23089.44</b>	
WINDSOR COUNTY	NORWICH	VT-10A	VT-10A	0.522	2756.16	NHS, DIVIDED
WINDSOR COUNTY	NORWICH	VT-10A	VT-10A	0.522	2756.16	
		<b>VT-10A TOTAL</b>		<b>1.044</b>	<b>5512.32</b>	

NSH = NAMED STATE HIGHWAY  
NHS = NATIONAL HIGHWAY SYSTEM.

6 INCH = ROUTES THAT SHOULD BE MARKED AS 6 INCH LINES. THESE ARE ESTIMATED ROUTES. MARKINGS SHALL MATCH EXISTING OR AS DIRECTED BY THE ENGINEER.

NIGHT WORK = AREAS THAT ARE DESIGNATED FOR NIGHT WORK.  
DIVIDED = AREAS THAT HAVE DIVIDED SEGMENTS. EACH SEGMENT IS MEASURED IN ONE DIRECTION.

ROUNDABOUT = ROUTES THAT HAVE ROUNDABOUTS.

SEGMENT LENGTH INFORMATION REPRESENTS CENTERLINE MILES. HISTORIC DATA WAS USED TO CORRELATE CENTERLINE MILES OF ROADWAY TO LINEAR FEET OF PAINTED LINE.

PROJECT NAME:	STATEWIDE SOUTHEAST REGION
PROJECT NUMBER:	STPG MARK(308)
FILE NAME:	z16+087road11st.dgn
PROJECT LEADER:	C. LATHROP
DESIGNED BY:	P. DAY
ROAD QUANTITY SHEET 1	
PLOT DATE:	2/9/2017
DRAWN BY:	P. DAY
CHECKED BY:	C. LATHROP
SHEET	5 OF 16

SUMMARY BY ROUTE OF STATE HIGHWAYS AND CLASS 1 TOWN HIGHWAYS

COUNTY	TOWN NAME	ROUTE NAME	HIGHWAY SIGN	MILEAGE	LINEAR FEET	COMMENTS
WINDHAM COUNTY	LONDONDERRY	VT-11	VT-11	7.556	39895.68	
WINDHAM COUNTY	WINDHAM	VT-11	VT-11	0.356	1879.68	
WINDSOR COUNTY	ANDOVER	VT-11	VT-11	3.678	19419.84	
WINDSOR COUNTY	CHESTER	TH-2	VT-11	0.833	4398.24	
WINDSOR COUNTY	CHESTER	VT-11	VT-11	7.504	39621.12	
WINDSOR COUNTY	SPRINGFIELD	VT-11	VT-11	5.382	28416.96	
WINDSOR COUNTY	SPRINGFIELD	TH-1	VT-11	2.739	14461.92	
WINDSOR COUNTY	SPRINGFIELD	TH-1	VT-11	0.082	432.96	
WINDSOR COUNTY	SPRINGFIELD	TH-1	VT-11	0.022	116.16	RAMPS
WINDSOR COUNTY	SPRINGFIELD	TH-1	VT-11	0.040	211.20	
WINDSOR COUNTY	SPRINGFIELD	TH-1	VT-11	0.062	327.36	
		<b>VT-11 TOTAL</b>		<b>28.254</b>	<b>149181.12</b>	
WINDSOR COUNTY	WEATHERSFIELD	VT-12	VT-12	0.394	2080.32	NHS
WINDSOR COUNTY	WEATHERSFIELD	VT-12	VT-12	0.044	232.32	NHS, DIVIDED
WINDSOR COUNTY	WEATHERSFIELD	VT-12	VT-12	0.027	142.56	
WINDSOR COUNTY	HARTLAND	VT-12	VT-12	7.705	40682.40	
WINDSOR COUNTY	HARTLAND	VT-12	VT-12	0.042	221.76	RAMP
WINDSOR COUNTY	WOODSTOCK	TH-3	VT-12	0.710	3748.80	
WINDSOR COUNTY	WOODSTOCK	VT-12	VT-12	3.298	17413.44	
WINDSOR COUNTY	POMFRET	VT-12	VT-12	1.383	7302.24	
WINDSOR COUNTY	BARNARD	VT-12	VT-12	9.615	50767.20	
WINDSOR COUNTY	BETHEL	TH-1	VT-12	0.892	4709.76	
WINDSOR COUNTY	BETHEL	VT-12	VT-12	6.127	32350.56	
ORANGE COUNTY	RANDOLPH	TH-1	VT-12	1.603	8463.84	
ORANGE COUNTY	RANDOLPH	VT-12	VT-12	5.155	27218.40	
ORANGE COUNTY	BRAINTREE	VT-12	VT-12	1.556	8215.68	
ORANGE COUNTY	BROOKFIELD	VT-12	VT-12	5.525	29172.00	
WASHINGTON COUNTY	ROXBURY	VT-12	VT-12	1.484	7835.52	
WASHINGTON COUNTY	NORTHFIELD	TH-1	VT-12	1.787	9435.36	
WASHINGTON COUNTY	NORTHFIELD	VT-12	VT-12	4.475	23628.00	
		<b>VT-12 TOTAL</b>		<b>51.822</b>	<b>273620.16</b>	
ORANGE COUNTY	RANDOLPH	TH-2	VT-12A	0.398	2101.44	
ORANGE COUNTY	RANDOLPH	VT-12A	VT-12A	0.877	4630.56	
ORANGE COUNTY	RANDOLPH	TH-4	VT-12A	0.030	158.40	
ORANGE COUNTY	BRAINTREE	VT-12A	VT-12A	7.189	37957.92	
ADDISON COUNTY	GRANVILLE	VT-12A	VT-12A	1.687	8907.36	
WASHINGTON COUNTY	ROXBURY	VT-12A	VT-12A	6.215	32815.20	
WASHINGTON COUNTY	NORTHFIELD	TH-2	VT-12A	0.401	2117.28	
WASHINGTON COUNTY	NORTHFIELD	VT-12A	VT-12A	4.075	21516.00	
		<b>VT-12A TOTAL</b>		<b>20.872</b>	<b>110204.16</b>	
WINDSOR COUNTY	HARTFORD	TH-1	VT-14	1.477	7798.56	
WINDSOR COUNTY	HARTFORD	VT-14	VT-14	6.379	33681.12	
WINDSOR COUNTY	SHARON	VT-14	VT-14	7.565	39943.20	
WINDSOR COUNTY	ROYALTON	VT-14	VT-14	9.121	48158.88	
WINDSOR COUNTY	BETHEL	VT-14	VT-14	0.890	4699.20	
ORANGE COUNTY	RANDOLPH	VT-14	VT-14	7.734	40835.52	
ORANGE COUNTY	BROOKFIELD	VT-14	VT-14	6.677	35254.56	
ORANGE COUNTY	WILLIAMSTOWN	VT-14	VT-14	6.833	36078.24	
		<b>VT-14 TOTAL</b>		<b>46.676</b>	<b>246449.28</b>	
WINDHAM COUNTY	BRATTLEBORO	TH-3	VT-30	0.326	1721.28	
WINDHAM COUNTY	BRATTLEBORO	VT-30	VT-30	3.254	17181.12	
WINDHAM COUNTY	DUMMERSTON	VT-30	VT-30	5.097	26912.16	
WINDHAM COUNTY	NEWFANE	VT-30	VT-30	5.662	29895.36	
WINDHAM COUNTY	TOWNSHEND	VT-30	VT-30	7.357	38844.96	
WINDHAM COUNTY	JAMAICA	VT-30	VT-30	10.119	53428.32	
		<b>VT-30 TOTAL</b>		<b>31.815</b>	<b>167983.20</b>	
WINDSOR COUNTY	READING	VT-44	VT-44	0.202	1066.56	
WINDSOR COUNTY	WEST WINDSOR	VT-44	VT-44	5.044	26632.32	
WINDSOR COUNTY	WINDSOR	TH-2	VT-44	3.335	17608.80	
WINDSOR COUNTY	WINDSOR	VT-44	VT-44	1.607	8484.96	
		<b>VT-44 TOTAL</b>		<b>10.188</b>	<b>53792.64</b>	

COUNTY	TOWN NAME	ROUTE NAME	HIGHWAY SIGN	MILEAGE	LINEAR FEET	COMMENTS
WINDSOR COUNTY	WEATHERSFIELD	VT-44A	VT-44A	0.501	2645.28	
WINDSOR COUNTY	WINDSOR	VT-44A	VT-44A	2.493	13163.04	
		<b>VT-44A TOTAL</b>		<b>2.994</b>	<b>15808.32</b>	
WASHINGTON COUNTY	NORTHFIELD	VT-64	VT-64	2.547	13448.16	
ORANGE COUNTY	WILLIAMSTOWN	VT-64	VT-64	4.223	22297.44	
		<b>VT-64 TOTAL</b>		<b>6.770</b>	<b>35745.60</b>	
ORANGE COUNTY	BROOKFIELD	VT-65	VT-65	2.235	11800.80	
		<b>VT-65 TOTAL</b>		<b>2.235</b>	<b>11800.80</b>	
ORANGE COUNTY	RANDOLPH	TH-3	VT-66	0.429	2265.12	
ORANGE COUNTY	RANDOLPH	VT-66	VT-66	6.908	36474.24	
ORANGE COUNTY	RANDOLPH	VT-66	VT-66	0.284	1499.52	DIVIDED
ORANGE COUNTY	RANDOLPH	VT-66	VT-66	0.233	1230.24	
		<b>VT-66 TOTAL</b>		<b>7.854</b>	<b>41469.12</b>	
WINDSOR COUNTY	ROCHESTER	VT-73	VT-73	8.782	46368.96	
		<b>VT-73 TOTAL</b>		<b>8.782</b>	<b>46368.96</b>	
WINDHAM COUNTY	WARDSBORO	VT-100	VT-100	7.373	38929.44	
WINDHAM COUNTY	JAMAICA	VT-100	VT-100	4.556	24055.68	
WINDHAM COUNTY	LONDONDERRY	VT-100	VT-100	7.646	40370.88	
WINDSOR COUNTY	WESTON	VT-100	VT-100	8.399	44346.72	
WINDSOR COUNTY	ANDOVER	VT-100	VT-100	0.208	1098.24	
WINDSOR COUNTY	BRIDGEWATER	VT-100	VT-100	0.967	5105.76	
WINDSOR COUNTY	STOCKBRIDGE	VT-100	VT-100	5.113	26996.64	
WINDSOR COUNTY	ROCHESTER	VT-100	VT-100	8.353	44103.84	
ADDISON COUNTY	HANCOCK	VT-100	VT-100	2.511	13258.08	
ADDISON COUNTY	GRANVILLE	VT-100	VT-100	9.687	51147.36	
		<b>VT-100 TOTAL</b>		<b>54.813</b>	<b>289412.64</b>	
WINDSOR COUNTY	BRIDGEWATER	VT-100A	VT-100A	2.209	11663.52	
		<b>VT-100A TOTAL</b>		<b>2.209</b>	<b>11663.52</b>	
WINDHAM COUNTY	ROCKINGHAM	VT-103	VT-103	6.753	35655.84	
WINDSOR COUNTY	CHESTER	TH-1	VT-103	1.667	8801.76	NHS
WINDSOR COUNTY	CHESTER	VT-103	VT-103	8.063	42572.64	
WINDSOR COUNTY	CAVENDISH	VT-103	VT-103	3.741	19752.48	
		<b>VT-103 TOTAL</b>		<b>20.224</b>	<b>106782.72</b>	

NSH = NAMED STATE HIGHWAY  
 NHS = NATIONAL HIGHWAY SYSTEM.

6 INCH = ROUTES THAT SHOULD BE MARKED AS 6 INCH LINES.  
 THESE ARE ESTIMATED ROUTES. MARKINGS SHALL MATCH  
 EXISTING OR AS DIRECTED BY THE ENGINEER.

NIGHT WORK = AREAS THAT ARE DESIGNATED FOR NIGHT WORK.  
 DIVIDED = AREAS THAT HAVE DIVIDED SEGMENTS. EACH SEGMENT  
 IS MEASURED IN ONE DIRECTION.

ROUNDOABOUT = ROUTES THAT HAVE ROUNDOABOUTS.

SEGMENT LENGTH INFORMATION REPRESENTS CENTERLINE MILES.  
 HISTORIC DATA WAS USED TO CORRELATE CENTERLINE MILES OF  
 ROADWAY TO LINEAR FEET OF PAINTED LINE.

PROJECT NAME:	STATEWIDE SOUTHEAST REGION
PROJECT NUMBER:	STPG MARK(308)
FILE NAME:	z16+087road11st.dgn
PROJECT LEADER:	C. LATHROP
DESIGNED BY:	P. DAY
ROAD QUANTITY SHEET 2	
PLOT DATE:	2/9/2017
DRAWN BY:	P. DAY
CHECKED BY:	C. LATHROP
SHEET	6 OF 16

SUMMARY BY ROUTE OF STATE HIGHWAYS AND CLASS 1 TOWN HIGHWAYS

COUNTY	TOWN NAME	ROUTE NAME	HIGHWAY SIGN	MILEAGE	LINEAR FEET	COMMENTS
WINDSOR COUNTY	SPRINGFIELD	TH-2	VT-106	0.058	306.24	
WINDSOR COUNTY	SPRINGFIELD	VT-106	VT-106	3.740	19747.20	
WINDSOR COUNTY	SPRINGFIELD	VT-106	VT-106	0.096	506.88	
WINDSOR COUNTY	SPRINGFIELD	VT-106	VT-106	0.057	300.96	RAMPS
WINDSOR COUNTY	WEATHERSFIELD	VT-106	VT-106	7.226	38153.28	
WINDSOR COUNTY	CAVENDISH	VT-106	VT-106	0.429	2265.12	
WINDSOR COUNTY	READING	VT-106	VT-106	7.277	38422.56	
WINDSOR COUNTY	WOODSTOCK	TH-4	VT-106	0.680	3590.40	
WINDSOR COUNTY	WOODSTOCK	VT-106	VT-106	6.553	34599.84	
			<b>VT-106 TOTAL</b>	<b>26.116</b>	<b>137892.48</b>	
WINDSOR COUNTY	STOCKBRIDGE	VT-107	VT-107	6.679	35265.12	
WINDSOR COUNTY	BETHEL	VT-107	VT-107	4.273	22561.44	
WINDSOR COUNTY	BETHEL	VT-107	VT-107	0.071	374.88	RAMP
WINDSOR COUNTY	ROYALTON	VT-107	VT-107	2.056	10855.68	
WINDSOR COUNTY	ROYALTON	VT-107	VT-107	0.474	2502.72	DIVIDED
WINDSOR COUNTY	ROYALTON	VT-107	VT-107	0.474	2502.72	
			<b>VT-107 TOTAL</b>	<b>14.027</b>	<b>74062.56</b>	
WINDSOR COUNTY	ROYALTON	VT-110	VT-110	2.320	12249.60	
ORANGE COUNTY	TUNBRIDGE	VT-110	VT-110	7.934	41891.52	
ORANGE COUNTY	CHELSEA	VT-110	VT-110	6.960	36748.80	
			<b>VT-110 TOTAL</b>	<b>17.214</b>	<b>90889.92</b>	
WINDHAM COUNTY	HALIFAX	VT-112	VT-112	5.846	30866.88	
			<b>VT-112 TOTAL</b>	<b>5.846</b>	<b>30866.88</b>	
ORANGE COUNTY	CHELSEA	VT-113	VT-113	3.440	18163.20	
ORANGE COUNTY	VERSHIRE	VT-113	VT-113	7.731	40819.68	
ORANGE COUNTY	WEST FAIRLEE	VT-113	VT-113	2.848	15037.44	
ORANGE COUNTY	THETFORD	VT-113	VT-113	8.448	44605.44	
ORANGE COUNTY	THETFORD	VT-113	VT-113	0.325	1716.00	DIVIDED
ORANGE COUNTY	THETFORD	VT-113	VT-113	0.336	1774.08	
			<b>VT-113 TOTAL</b>	<b>23.128</b>	<b>122115.84</b>	

COUNTY	TOWN NAME	ROUTE NAME	HIGHWAY SIGN	MILEAGE	LINEAR FEET	COMMENTS
WINDHAM COUNTY	WESTMINSTER	VT-123	VT-123	0.313	1652.64	
WINDHAM COUNTY	WESTMINSTER	VT-123	VT-123	0.051	269.28	RAMP
			<b>VT-123 TOTAL</b>	<b>0.364</b>	<b>1921.92</b>	
ADDISON COUNTY	HANCOCK	VT-125	VT-125	7.246	38258.88	
			<b>VT-125 TOTAL</b>	<b>7.246</b>	<b>38258.88</b>	
WINDSOR COUNTY	CAVENDISH	VT-131	VT-131	7.652	40402.56	
WINDSOR COUNTY	WEATHERSFIELD	VT-131	VT-131	8.145	43005.60	
WINDSOR COUNTY	WEATHERSFIELD	VT-131	VT-131	0.341	1800.48	NHS
WINDSOR COUNTY	WEATHERSFIELD	VT-131	VT-131	0.161	850.08	NHS, DIVIDED
WINDSOR COUNTY	WEATHERSFIELD	VT-131	VT-131	0.161	850.08	
WINDSOR COUNTY	WEATHERSFIELD	VT-131	VT-131	0.042	221.76	NHS, RAMP
			<b>VT-131 TOTAL</b>	<b>16.502</b>	<b>87130.56</b>	
WINDSOR COUNTY	SHARON	VT-132	VT-132	0.227	1198.56	
			<b>VT-132 TOTAL</b>	<b>0.227</b>	<b>1198.56</b>	
WINDHAM COUNTY	VERNON	VT-142	VT-142	8.680	45830.40	
WINDHAM COUNTY	BRATTLEBORO	TH-4	VT-142	1.069	5644.32	
WINDHAM COUNTY	BRATTLEBORO	VT-142	VT-142	1.098	5797.44	
			<b>VT-142 TOTAL</b>	<b>10.847</b>	<b>57272.16</b>	
WINDSOR COUNTY	WESTON	VT-155	VT-155	2.275	12012.00	
			<b>VT-155 TOTAL</b>	<b>2.275</b>	<b>12012.00</b>	
ORANGE COUNTY	THETFORD	VT-244	VT-244	1.489	7861.92	
ORANGE COUNTY	WEST FAIRLEE	VT-244	VT-244	1.505	7946.40	
			<b>VT-244 TOTAL</b>	<b>2.994</b>	<b>15808.32</b>	

NSH = NAMED STATE HIGHWAY  
 NHS = NATIONAL HIGHWAY SYSTEM.

6 INCH = ROUTES THAT SHOULD BE MARKED AS 6 INCH LINES.  
 THESE ARE ESTIMATED ROUTES. MARKINGS SHALL MATCH  
 EXISTING OR AS DIRECTED BY THE ENGINEER.

NIGHT WORK = AREAS THAT ARE DESIGNATED FOR NIGHT WORK.  
 DIVIDED = AREAS THAT HAVE DIVIDED SEGMENTS. EACH SEGMENT  
 IS MEASURED IN ONE DIRECTION.

ROUNDBOUT = ROUTES THAT HAVE ROUNDBOUTS.

SEGMENT LENGTH INFORMATION REPRESENTS CENTERLINE MILES.  
 HISTORIC DATA WAS USED TO CORRELATE CENTERLINE MILES OF  
 ROADWAY TO LINEAR FEET OF PAINTED LINE.

PROJECT NAME:	STATEWIDE SOUTHEAST REGION
PROJECT NUMBER:	STPG MARK(308)
FILE NAME:	z16+087road11st.dgn
PROJECT LEADER:	C. LATHROP
DESIGNED BY:	P. DAY
ROAD QUANTITY SHEET 3	
PLOT DATE:	2/9/2017
DRAWN BY:	P. DAY
CHECKED BY:	C. LATHROP
SHEET	7 OF 16

SUMMARY BY ROUTE OF STATE HIGHWAYS AND CLASS 1 TOWN HIGHWAYS

BRATTLEBORO STATE HIGHWAY	0.27
NORWICH STATE HIGHWAY	1.168
PUTNEY STATE HIGHWAY	0.362
QUECHEE STATE HIGHWAY	0.246
WESTMINSTER STATE HIGHWAY	0.915
HARTFORD STATE HIGHWAY	0.744
US-4	27.994
US-5	97.426
VT-9	15.621
VT-10	4.373
VT-10A	1.044
VT-11	28.254
VT-12	51.822
VT-12A	20.872
VT-14	46.676
VT-30	31.815
VT-44	10.188
VT-44A	2.994
VT-64	6.77
VT-65	2.235
VT-66	7.854
VT-73	8.782
VT-100	54.813
VT-100A	2.209
VT-103	20.224
VT-106	26.116
VT-107	14.027
VT-110	17.214
VT-112	5.846
VT-113	23.128
VT-123	0.364
VT-125	7.246
VT-131	16.502
VT-132	0.227
VT-142	10.847
VT-155	2.275
VT-244	2.994
<b>SOUTHEAST TOTAL</b>	<b>572.457</b>

NSH = NAMED STATE HIGHWAY

NHS = NATIONAL HIGHWAY SYSTEM.

6 INCH = ROUTES THAT SHOULD BE MARKED AS 6 INCH LINES. THESE ARE ESTIMATED ROUTES. MARKINGS SHALL MATCH EXISTING OR AS DIRECTED BY THE ENGINEER.

NIGHT WORK = AREAS THAT ARE DESIGNATED FOR NIGHT WORK.

DIVIDED = AREAS THAT HAVE DIVIDED SEGMENTS. EACH SEGMENT IS MEASURED IN ONE DIRECTION.

ROUNDBOUT = ROUTES THAT HAVE ROUNDBOUTS.

SEGMENT LENGTH INFORMATION REPRESENTS CENTERLINE MILES. HISTORIC DATA WAS USED TO CORRELATE CENTERLINE MILES OF ROADWAY TO LINEAR FEET OF PAINTED LINE.

PROJECT NAME:	STATEWIDE SOUTHEAST REGION
PROJECT NUMBER:	STPG MARK(308)
FILE NAME: z16+087roadlist.dgn	PLOT DATE: 2/9/2017
PROJECT LEADER: C. LATHROP	DRAWN BY: P. DAY
DESIGNED BY: P. DAY	CHECKED BY: C. LATHROP
ROAD SUMMARY SHEET	SHEET 8 OF 16

## SUMMARY BY COUNTY OF CLASS 2 TOWN HIGHWAYS

COUNTY	TOWN	TH NUMBER	TH NAME	MILEAGE	LINEAR FT
ORANGE COUNTY	BRAINTREE	TH-2	BRAINTREE HILL RD	1.119	5,908.32
ORANGE COUNTY	BRAINTREE	TH-2	THRESHER RD	0.534	2,819.52
ORANGE COUNTY	BROOKFIELD	TH-1	NORTHFIELD RD	1.130	5,966.40
ORANGE COUNTY	BROOKFIELD	TH-1	STONE RD	0.086	454.08
ORANGE COUNTY	BROOKFIELD	TH-2	RIDGE RD	3.260	17,212.80
ORANGE COUNTY	BROOKFIELD	TH-5	E RANDOLPH RD	0.480	2,534.40
ORANGE COUNTY	BROOKFIELD	TH-7	STONE RD	0.090	475.20
ORANGE COUNTY	BROOKFIELD	TH-7	NORTHFIELD RD FRK	0.020	105.60
ORANGE COUNTY	CHELSEA	TH-1	E RANDOLPH RD	2.890	15,259.20
ORANGE COUNTY	CHELSEA	TH-2	UPPER VILLAGE RD	1.600	8,448.00
ORANGE COUNTY	RANDOLPH	TH-1	RIDGE RD	3.310	17,476.80
ORANGE COUNTY	RANDOLPH	TH-2	E BETHEL RD	2.230	11,774.40
ORANGE COUNTY	RANDOLPH	TH-3	CHELSEA MOUNTAIN RD	3.560	18,796.80
ORANGE COUNTY	RANDOLPH	TH-6	WINDOVER RD	0.470	2,481.60
ORANGE COUNTY	RANDOLPH	TH-8	BEANVILLE RD	1.230	6,494.40
ORANGE COUNTY	RANDOLPH	TH-8	PLEASANT ST	0.200	1,056.00
ORANGE COUNTY	RANDOLPH	TH-8	S PLEASANT ST	0.420	2,217.60
ORANGE COUNTY	STRAFFORD	TH-1	ROUTE 132	4.630	24,446.40
ORANGE COUNTY	STRAFFORD	TH-2	JUSTIN MORRILL MEM HWY	2.280	12,038.40
ORANGE COUNTY	STRAFFORD	TH-3	MILLER POND RD	2.021	10,670.88
ORANGE COUNTY	THETFORD	TH-1	ROUTE 132	5.170	27,297.60
ORANGE COUNTY	THETFORD	TH-2	WEST FAIRLEE RD	0.630	3,326.40
ORANGE COUNTY	THETFORD	TH-3	ACADEMY RD	2.800	14,784.00
ORANGE COUNTY	THETFORD	TH-3	MAIN ST	0.200	1,056.00
ORANGE COUNTY	THETFORD	TH-4	MILLER POND RD	0.770	4,065.60
ORANGE COUNTY	THETFORD	TH-5	LATHAM RD	2.390	12,619.20
ORANGE COUNTY	THETFORD	TH-6	TUCKER HILL RD	2.270	11,985.60
ORANGE COUNTY	TUNBRIDGE	TH-1	STRAFFORD RD	4.840	25,555.20
ORANGE COUNTY	VERSHIRE	TH-1	GOOSE GREEN RD	1.480	7,814.40
ORANGE COUNTY	VERSHIRE	TH-2	S VERSHIRE RD	0.170	897.60
ORANGE COUNTY	VERSHIRE	TH-2	MILLER POND RD	0.292	1,541.76
ORANGE COUNTY	VERSHIRE	TH-3	EAGLE HOLLOW RD	2.380	12,566.40
ORANGE COUNTY	WEST FAIRLEE	TH-1	WEST FAIRLEE RD	0.280	1,478.40
ORANGE COUNTY	WEST FAIRLEE	TH-1	CROSSROAD	0.440	2,323.20
ORANGE COUNTY	WEST FAIRLEE	TH-2	WILD HILL RD	1.345	7,101.60
ORANGE COUNTY	WEST FAIRLEE	TH-2	MIDDLEBROOK RD	4.400	23,232.00
ORANGE COUNTY	WEST FAIRLEE	TH-3	BEANVILLE RD	0.900	4,752.00
ORANGE COUNTY	WILLIAMSTOWN	TH-1	COGSWELL ST	0.480	2,534.40
ORANGE COUNTY	WILLIAMSTOWN	TH-1	GRANITEVILLE RD	3.180	16,790.40
ORANGE COUNTY	WILLIAMSTOWN	TH-1	MEADOW ST	0.300	1,584.00
ORANGE COUNTY	WILLIAMSTOWN	TH-3	CHELSEA RD	3.080	16,262.40
ORANGE COUNTY	WILLIAMSTOWN	TH-4	ROOD POND RD	0.020	105.60
ORANGE COUNTY	WILLIAMSTOWN	TH-6	ROBAR RD	0.530	2,798.40
ORANGE COUNTY	WILLIAMSTOWN	TH-7	PIRIE RD	0.850	4,488.00
ORANGE COUNTY	WILLIAMSTOWN	TH-8	FALLS BRIDGE RD	1.400	7,392.00
<b>ORANGE COUNTY TOTAL</b>				<b>72.157</b>	<b>380,988.96</b>

PROJECT NAME:	STATEWIDE SOUTHEAST REGION
PROJECT NUMBER:	STPG MARK(308)
FILE NAME: z16+087.dgn	PLOT DATE: 2/9/2017
PROJECT LEADER: C. LATHROP	DRAWN BY: P. DAY
DESIGNED BY: P. DAY	CHECKED BY: C. LATHROP
CLASS 2 TOWN HIGHWAY QUANTITY SHEET 1	SHEET 9 OF 16

## SUMMARY BY COUNTY OF CLASS 2 TOWN HIGHWAYS

COUNTY	TOWN	TH NUMBER	TH NAME	MILEAGE	LINEAR FT
WASHINGTON COUNTY	NORTHFIELD	TH-3	COX BROOK RD	1.350	7,128.00
WASHINGTON COUNTY	NORTHFIELD	TH-4	BERLIN POND RD	0.768	4,055.04
WASHINGTON COUNTY	NORTHFIELD	TH-5	LOVERS LN	0.190	1,003.20
WASHINGTON COUNTY	ROXBURY	TH-1	WARREN MTN RD	1.730	9,134.40
<b>WASHINGTON COUNTY TOTAL</b>				<b>4.038</b>	<b>21,320.64</b>

PROJECT NAME: STATEWIDE SOUTHEAST REGION	
PROJECT NUMBER: STPG MARK(308)	
FILE NAME: z16+087.dgn	PLOT DATE: 2/9/2017
PROJECT LEADER: C. LATHROP	DRAWN BY: P. DAY
DESIGNED BY: P. DAY	CHECKED BY: C. LATHROP
CLASS 2 TOWN HIGHWAY QUANTITY SHEET 2 SHEET 10 OF 16	

## SUMMARY BY COUNTY OF CLASS 2 TOWN HIGHWAYS

COUNTY	TOWN	TH NUMBER	TH NAME	MILEAGE	LINEAR FT
WINDHAM COUNTY	ATHENS	TH-1	ROUTE 35	4.060	21,436.80
WINDHAM COUNTY	ATHENS	TH-2	BROOKLINE RD	1.434	7,571.52
WINDHAM COUNTY	BRATTLEBORO	TH-5	UPPER DUMMERSTON RD	2.850	15,048.00
WINDHAM COUNTY	BRATTLEBORO	TH-6	GREENLEAF ST	0.750	3,960.00
WINDHAM COUNTY	BRATTLEBORO	TH-6	HINESBURG RD	3.050	16,104.00
WINDHAM COUNTY	BRATTLEBORO	TH-7	BRIDGE ST	0.080	422.40
WINDHAM COUNTY	BRATTLEBORO	TH-9	SOUTH MAIN ST	1.170	6,177.60
WINDHAM COUNTY	BRATTLEBORO	TH-9	OLD GUILFORD RD	0.890	4,699.20
WINDHAM COUNTY	BRATTLEBORO	TH-10	FAIRVIEW ST	0.500	2,640.00
WINDHAM COUNTY	BRATTLEBORO	TH-10	GUILFORD ST	0.470	2,481.60
WINDHAM COUNTY	BRATTLEBORO	TH-10	MAPLE ST	0.700	3,696.00
WINDHAM COUNTY	BRATTLEBORO	TH-11	ELLIOT ST	0.170	897.60
WINDHAM COUNTY	BRATTLEBORO	TH-11	ELM ST	0.230	1,214.40
WINDHAM COUNTY	BROOKLINE	TH-1	GRASSY BROOK RD	4.950	26,136.00
WINDHAM COUNTY	DUMMERSTON	TH-1	EAST-WEST RD	4.430	23,390.40
WINDHAM COUNTY	DUMMERSTON	TH-1	W DUMMERSTON COVERED BRIDGE	0.060	316.80
WINDHAM COUNTY	DUMMERSTON	TH-2	BUNKER RD	0.370	1,953.60
WINDHAM COUNTY	DUMMERSTON	TH-2	MIDDLE RD	3.200	16,896.00
WINDHAM COUNTY	DUMMERSTON	TH-3	SCHOOL HOUSE RD	0.880	4,646.40
WINDHAM COUNTY	DUMMERSTON	TH-4	UPPER DUMMERSTON RD	0.800	4,224.00
WINDHAM COUNTY	DUMMERSTON	TH-5	WILLIAMSVILLE RD	0.060	316.80
WINDHAM COUNTY	DUMMERSTON	TH-6	HOUGHTON BROOK RD	0.390	2,059.20
WINDHAM COUNTY	DUMMERSTON	TH-6	JOHNSON'S CURVE RD	0.270	1,425.60
WINDHAM COUNTY	GRAFTON	TH-1	ROUTE 121 E	4.070	21,489.60
WINDHAM COUNTY	GRAFTON	TH-1	MAIN ST	0.210	1,108.80
WINDHAM COUNTY	GRAFTON	TH-1	HOUGHTONVILLE RD	1.936	10,222.08
WINDHAM COUNTY	GRAFTON	TH-2	TOWNSHEND RD	3.730	19,694.40
WINDHAM COUNTY	GRAFTON	TH-3	CHESTER RD	4.540	23,971.20
WINDHAM COUNTY	GRAFTON	TH-4	ATHENS RD	0.260	1,372.80
WINDHAM COUNTY	GUILFORD	TH-1	GUILFORD CENTER RD	4.720	24,921.60
WINDHAM COUNTY	GUILFORD	TH-2	HINESBURG RD	2.372	12,524.16
WINDHAM COUNTY	GUILFORD	TH-3	TYLER HILL RD	0.210	1,108.80
WINDHAM COUNTY	GUILFORD	TH-4	WEATHERHEAD HOLLOW RD	5.090	26,875.20
WINDHAM COUNTY	HALIFAX	TH-1	GREEN RIVER RD	5.130	27,086.40
WINDHAM COUNTY	HALIFAX	TH-1	BRANCH RD	2.220	11,721.60
WINDHAM COUNTY	HALIFAX	TH-1	BROOK RD	2.510	13,252.80
WINDHAM COUNTY	HALIFAX	TH-2	JACKSONVILLE STAGE RD	0.548	2,893.44
WINDHAM COUNTY	JAMAICA	TH-1	PIKES FALLS RD	4.342	22,925.76
WINDHAM COUNTY	JAMAICA	TH-2	WINDHAM HILL RD	0.440	2,323.20
WINDHAM COUNTY	LONDONDERRY	TH-1	LANDGROVE RD	2.550	13,464.00
WINDHAM COUNTY	LONDONDERRY	TH-2	MAIN ST	0.670	3,537.60
WINDHAM COUNTY	LONDONDERRY	TH-2	THOMPSONBURG RD	2.530	13,358.40
WINDHAM COUNTY	LONDONDERRY	TH-3	ROUTE 121	0.340	1,795.20
<b>WINDHAM COUNTY SHEET 1 TOTAL</b>				<b>80.182</b>	<b>423,360.96</b>

PROJECT NAME:	STATEWIDE SOUTHEAST REGION
PROJECT NUMBER:	STPG MARK(308)
FILE NAME: z16+087.dgn	PLOT DATE: 2/9/2017
PROJECT LEADER: C. LATHROP	DRAWN BY: P. DAY
DESIGNED BY: P. DAY	CHECKED BY: C. LATHROP
CLASS 2 TOWN HIGHWAY QUANTITY SHEET 3 SHEET 11 OF 16	

## SUMMARY BY COUNTY OF CLASS 2 TOWN HIGHWAYS

COUNTY	TOWN	TH NUMBER	TH NAME	MILEAGE	LINEAR FT
WINDHAM COUNTY	LONDONDERRY	TH-4	MAGIC MOUNTAIN ACCESS RD	0.490	2,587.20
WINDHAM COUNTY	LONDONDERRY	TH-5	MIDDLETOWN RD	2.590	13,675.20
WINDHAM COUNTY	LONDONDERRY	TH-6	WINHALL HOLLOW RD	3.020	15,945.60
WINDHAM COUNTY	MARLBORO	TH-1	AUGUR HOLE RD	1.675	8,844.00
WINDHAM COUNTY	MARLBORO	TH-2	HIGLEY HILL RD	1.479	7,809.12
WINDHAM COUNTY	MARLBORO	TH-3	SOUTH RD	2.710	14,308.80
WINDHAM COUNTY	NEWFANE	TH-1	COURT ST	0.070	369.60
WINDHAM COUNTY	NEWFANE	TH-1	S WARDSBORO RD	2.050	10,824.00
WINDHAM COUNTY	NEWFANE	TH-1	WEST ST	0.250	1,320.00
WINDHAM COUNTY	NEWFANE	TH-2	DEPOT RD	1.910	10,084.80
WINDHAM COUNTY	NEWFANE	TH-2	DOVER RD	5.550	29,304.00
WINDHAM COUNTY	NEWFANE	TH-3	AUGER HOLE RD	0.980	5,174.40
WINDHAM COUNTY	NEWFANE	TH-4	RADWAY HILL RD	0.530	2,798.40
WINDHAM COUNTY	NEWFANE	TH-5	GRIMES HILL RD	1.660	8,764.80
WINDHAM COUNTY	PUTNEY	TH-1	KIMBALL HL	0.300	1,584.00
WINDHAM COUNTY	PUTNEY	TH-1	WESTMINSTER RD	3.180	16,790.40
WINDHAM COUNTY	PUTNEY	TH-2	WEST HILL	3.430	18,110.40
WINDHAM COUNTY	PUTNEY	TH-3	RIVER RD S	3.817	20,153.76
WINDHAM COUNTY	PUTNEY	TH-4	HOUGHTON BROOK RD	0.420	2,217.60
WINDHAM COUNTY	ROCKINGHAM	TH-1	MAIN ST	0.700	3,696.00
WINDHAM COUNTY	ROCKINGHAM	TH-1	SAXTONS RIVER RD	4.490	23,707.20
WINDHAM COUNTY	ROCKINGHAM	TH-2	PLEASANT VALLEY RD	4.670	24,657.60
WINDHAM COUNTY	ROCKINGHAM	TH-3	WESTMINSTER ST	0.320	1,689.60
WINDHAM COUNTY	ROCKINGHAM	TH-3	WESTMINSTER WEST RD	1.000	5,280.00
WINDHAM COUNTY	ROCKINGHAM	TH-4	BROCKWAYS MILLS RD	2.740	14,467.20
WINDHAM COUNTY	ROCKINGHAM	TH-5	BF SAXTONS RIVER RD	0.113	596.64
WINDHAM COUNTY	ROCKINGHAM	TH-5	OLD TERRANCE	0.246	1,298.88
WINDHAM COUNTY	ROCKINGHAM	TH-5	WESTMINSTER	0.258	1,362.24
WINDHAM COUNTY	ROCKINGHAM	TH-5	SQUARE	0.060	316.80
WINDHAM COUNTY	ROCKINGHAM	TH-5	ROCKINGHAM ST	0.513	2,708.64
WINDHAM COUNTY	ROCKINGHAM	TH-5	ROUTE 121	0.040	211.20
WINDHAM COUNTY	ROCKINGHAM	TH-5	WESTMINSTER ST	0.077	406.56
WINDHAM COUNTY	ROCKINGHAM	TH-6	BRIDGE ST	0.243	1,283.04
WINDHAM COUNTY	ROCKINGHAM	TH-6	SQUARE	0.006	31.68
WINDHAM COUNTY	ROCKINGHAM	TH-7	TH 7	0.040	211.20
WINDHAM COUNTY	TOWNSHEND	TH-1	GRAFTON RD	6.330	33,422.40
WINDHAM COUNTY	TOWNSHEND	TH-2	ATHENS RD	1.620	8,553.60
WINDHAM COUNTY	TOWNSHEND	TH-3	WINDHAM HILL RD	2.670	14,097.60
WINDHAM COUNTY	VERNON	TH-1	TYLER HILL RD	2.150	11,352.00
WINDHAM COUNTY	VERNON	TH-2	POND RD	3.890	20,539.20
WINDHAM COUNTY	VERNON	TH-3	HUCKLE HILL RD	1.820	9,609.60
WINDHAM COUNTY	WARDSBORO	TH-1	STRATTON ARLINGTON RD	1.210	6,388.80
WINDHAM COUNTY	WARDSBORO	TH-2	S WARDSBORO RD	3.010	15,892.80
<b>WINDHAM COUNTY SHEET 2 TOTAL</b>				<b>74.327</b>	<b>392,446.56</b>

PROJECT NAME:	STATEWIDE SOUTHEAST REGION
PROJECT NUMBER:	STPG MARK(308)
FILE NAME: z16+087.dgn	PLOT DATE: 2/9/2017
PROJECT LEADER: C. LATHROP	DRAWN BY: P. DAY
DESIGNED BY: P. DAY	CHECKED BY: C. LATHROP
CLASS 2 TOWN HIGHWAY QUANTITY SHEET 4 SHEET 12 OF 16	

## SUMMARY BY COUNTY OF CLASS 2 TOWN HIGHWAYS

COUNTY	TOWN	TH NUMBER	TH NAME	MILEAGE	LINEAR FT
WINDHAM COUNTY	WESTMINSTER	TH-1	ROUTE 121	1.830	9,662.40
WINDHAM COUNTY	WESTMINSTER	TH-2	WESTMINSTER WEST RD	7.900	41,712.00
WINDHAM COUNTY	WESTMINSTER	TH-3	WESTMINSTER HEIGHTS RD	1.540	8,131.20
WINDHAM COUNTY	WESTMINSTER	TH-3	SCHOOL ST	0.520	2,745.60
WINDHAM COUNTY	WESTMINSTER	TH-4	KURN HATTIN RD	2.810	14,836.80
WINDHAM COUNTY	WESTMINSTER	TH-4	PATCH RD	2.180	11,510.40
WINDHAM COUNTY	WESTMINSTER	TH-5	BACK WESTMINSTER RD	2.860	15,100.80
WINDHAM COUNTY	WESTMINSTER	TH-5	INTERSTATE 91 ACCESS RD	0.210	1,108.80
WINDHAM COUNTY	WINDHAM	TH-1	WINDHAM HILL RD	5.180	27,350.40
WINDHAM COUNTY	WINDHAM	TH-2	ROUTE 121	1.710	9,028.80
<b>WINDHAM COUNTY SHEET 3 TOTAL</b>				<b>26.740</b>	<b>141,187.20</b>
<b>WINDHAM COUNTY SHEET 1 TOTAL</b>				<b>80.182</b>	<b>423,360.96</b>
<b>WINDHAM COUNTY SHEET 2 TOTAL</b>				<b>74.327</b>	<b>392,446.56</b>
<b>WINDHAM COUNTY SHEET 3 TOTAL</b>				<b>26.740</b>	<b>141,187.20</b>
<b>WINDHAM COUNTY TOTAL</b>				<b>181.249</b>	<b>956,994.72</b>

PROJECT NAME: STATEWIDE SOUTHEAST REGION
PROJECT NUMBER: STPG MARK(308)
FILE NAME: z16+087.dgn
PROJECT LEADER: C. LATHROP
DESIGNED BY: P. DAY
CLASS 2 TOWN HIGHWAY QUANTITY SHEET 5
PLOT DATE: 2/9/2017
DRAWN BY: P. DAY
CHECKED BY: C. LATHROP
SHEET 13 OF 16

## SUMMARY BY COUNTY OF CLASS 2 TOWN HIGHWAYS

COUNTY	TOWN	TH NUMBER	TH NAME	MILEAGE	LINEAR FT
WINDSOR COUNTY	ANDOVER	TH-1	WESTON-ANDOVER RD	4.830	25,502.40
WINDSOR COUNTY	ANDOVER	TH-2	EAST HILL RD	2.370	12,513.60
WINDSOR COUNTY	BARNARD	TH-1	STAGE RD	1.200	6,336.00
WINDSOR COUNTY	BARNARD	TH-2	ROYALTON TURNPIKE	0.190	1,003.20
WINDSOR COUNTY	BARNARD	TH-3	NORTH RD	3.950	20,856.00
WINDSOR COUNTY	BETHEL	TH-2	CAMP BROOK RD	6.160	32,524.80
WINDSOR COUNTY	BETHEL	TH-3	FACTORY HILL RD	0.120	633.60
WINDSOR COUNTY	BETHEL	TH-3	RANDOLPH CENTER RD	0.440	2,323.20
WINDSOR COUNTY	BETHEL	TH-4	NORTH RD	0.890	4,699.20
WINDSOR COUNTY	BETHEL	TH-5	PEAVINE BLVD	1.660	8,764.80
WINDSOR COUNTY	BETHEL	TH-6	CHRISTIAN HILL RD	0.790	4,171.20
WINDSOR COUNTY	BRIDGEWATER	TH-1	BRIDGEWATER CTR RD	2.440	12,883.20
WINDSOR COUNTY	BRIDGEWATER	TH-1	CHATEAUGUAY RD	0.480	2,534.40
WINDSOR COUNTY	BRIDGEWATER	TH-2	N BRIDGEWATER RD	0.813	4,292.64
WINDSOR COUNTY	CAVENDISH	TH-1	DEPOT ST	0.600	3,168.00
WINDSOR COUNTY	CAVENDISH	TH-2	TARBELL HILL RD	3.120	16,473.60
WINDSOR COUNTY	CAVENDISH	TH-3	TWENTY MILE STREAM RD	3.800	20,064.00
WINDSOR COUNTY	CAVENDISH	TH-4	MILL ST	0.220	1,161.60
WINDSOR COUNTY	CHESTER	TH-3	GRAFTON RD	2.610	13,780.80
WINDSOR COUNTY	CHESTER	TH-4	DEPOT ST	0.189	997.92
WINDSOR COUNTY	CHESTER	TH-5	CHURCH ST	0.950	5,016.00
WINDSOR COUNTY	CHESTER	TH-6	GREEN MTN TRNPK	0.190	1,003.20
WINDSOR COUNTY	CHESTER	TH-6	PECK RD	0.260	1,372.80
WINDSOR COUNTY	CHESTER	TH-7	ANDOVER RD	1.480	7,814.40
WINDSOR COUNTY	CHESTER	TH-9	FLAMSTEAD RD	2.684	14,171.52
WINDSOR COUNTY	HARTFORD	TH-2	BRIDGE ST	0.144	760.32
WINDSOR COUNTY	HARTFORD	TH-2	N MAIN ST	0.250	1,320.00
WINDSOR COUNTY	HARTFORD	TH-2	BRIDGE ST	0.059	311.52
WINDSOR COUNTY	HARTFORD	TH-3	QUECHEE MAIN ST	3.420	18,057.60
WINDSOR COUNTY	HARTFORD	TH-4	DEWEYS MILLS RD	0.870	4,593.60
WINDSOR COUNTY	HARTFORD	TH-4	QUECHEE MAIN ST	1.880	9,926.40
WINDSOR COUNTY	HARTFORD	TH-4	QUECHEE WEST HARTFORD RD	5.220	27,561.60
WINDSOR COUNTY	HARTFORD	TH-5	POMFRET RD	0.830	4,382.40
WINDSOR COUNTY	HARTFORD	TH-6	VA CUTOFF RD	1.360	7,180.80
WINDSOR COUNTY	HARTFORD	TH-7	MILL RD	0.570	3,009.60
WINDSOR COUNTY	HARTFORD	TH-8	QUECHEE HARTLAND RD	1.600	8,448.00
WINDSOR COUNTY	HARTFORD	TH-8	WATERMAN HILL RD	0.190	1,003.20
WINDSOR COUNTY	HARTFORD	TH-9	CHRISTIAN ST	2.270	11,985.60
WINDSOR COUNTY	HARTFORD	TH-10	SYKES MOUNTAIN AVE	0.970	5,121.60
WINDSOR COUNTY	HARTLAND	TH-1	BROWNSVILLE RD	2.520	13,305.60
WINDSOR COUNTY	HARTLAND	TH-2	QUECHEE RD	6.050	31,944.00
WINDSOR COUNTY	HARTLAND	TH-3	COUNTY RD	1.120	5,913.60
WINDSOR COUNTY	HARTLAND	TH-4	CLAY HILL RD	2.854	15,069.12
WINDSOR COUNTY	NORWICH	TH-1	UNION VILLAGE RD	5.010	26,452.80
<b>WINDSOR COUNTY SHEET 1 TOTAL</b>				<b>79.623</b>	<b>420,409.44</b>

PROJECT NAME:	STATEWIDE SOUTHEAST REGION
PROJECT NUMBER:	STPG MARK(308)
FILE NAME: z16+087.dgn	PLOT DATE: 2/9/2017
PROJECT LEADER: C. LATHROP	DRAWN BY: P. DAY
DESIGNED BY: P. DAY	CHECKED BY: C. LATHROP
CLASS 2 TOWN HIGHWAY QUANTITY SHEET 6 SHEET 14 OF 16	

## SUMMARY BY COUNTY OF CLASS 2 TOWN HIGHWAYS

COUNTY	TOWN	TH NUMBER	TH NAME	MILEAGE	LINEAR FT
WINDSOR COUNTY	NORWICH	TH-1	MAIN ST	0.680	3,590.40
WINDSOR COUNTY	NORWICH	TH-2	BEAVER MEADOW RD	5.630	29,726.40
WINDSOR COUNTY	NORWICH	TH-3	ROUTE 132	2.830	14,942.40
WINDSOR COUNTY	NORWICH	TH-4	ACADEMY RD	0.400	2,112.00
WINDSOR COUNTY	POMFRET	TH-1	POMFRET RD	10.150	53,592.00
WINDSOR COUNTY	POMFRET	TH-2	STAGE RD	2.730	14,414.40
WINDSOR COUNTY	POMFRET	TH-3	HOWE HILL RD	1.770	9,345.60
WINDSOR COUNTY	READING	TH-1	TYSON RD	7.250	38,280.00
WINDSOR COUNTY	ROCHESTER	TH-1	BETHEL MOUNTAIN RD	4.100	21,648.00
WINDSOR COUNTY	ROCHESTER	TH-2	MIDDLE HOLLOW RD	0.470	2,481.60
WINDSOR COUNTY	ROCHESTER	TH-3	QUARRY HILL RD	1.790	9,451.20
WINDSOR COUNTY	ROYALTON	TH-1	CHELSEA ST	0.220	1,161.60
WINDSOR COUNTY	ROYALTON	TH-1	S WINDSOR ST	2.370	12,513.60
WINDSOR COUNTY	ROYALTON	TH-2	BROAD BROOK RD	0.550	2,904.00
WINDSOR COUNTY	ROYALTON	TH-3	DAIRY HILL RD	1.840	9,715.20
WINDSOR COUNTY	ROYALTON	TH-4	NORTH RD	2.220	11,721.60
WINDSOR COUNTY	ROYALTON	TH-5	N WINDSOR ST	1.160	6,124.80
WINDSOR COUNTY	ROYALTON	TH-5	BRIDGE ST	0.200	1,056.00
WINDSOR COUNTY	ROYALTON	TH-6	ROYALTON HILL RD	1.160	6,124.80
WINDSOR COUNTY	ROYALTON	TH-7	CHRISTIAN HILL RD	0.040	211.20
WINDSOR COUNTY	SHARON	TH-1	BEAVER MEADOW RD	0.530	2,798.40
WINDSOR COUNTY	SHARON	TH-2	ROUTE 132	4.020	21,225.60
WINDSOR COUNTY	SHARON	TH-3	RIVER RD	2.430	12,830.40
WINDSOR COUNTY	SHARON	TH-4	BROAD BROOK RD	0.300	1,584.00
WINDSOR COUNTY	SHARON	TH-5	HOWE HILL RD	2.720	14,361.60
WINDSOR COUNTY	SPRINGFIELD	TH-3	SKITCHEWAUG TRL	4.560	24,076.80
WINDSOR COUNTY	SPRINGFIELD	TH-3	SUMMER ST	1.190	6,283.20
WINDSOR COUNTY	SPRINGFIELD	TH-4	MAIN ST	0.010	52.80
WINDSOR COUNTY	SPRINGFIELD	TH-4	SOUTH ST	2.410	12,724.80
WINDSOR COUNTY	SPRINGFIELD	TH-4	BROCKWAY MILLS RD	2.830	14,942.40
WINDSOR COUNTY	SPRINGFIELD	TH-5	VALLEY ST	0.970	5,121.60
WINDSOR COUNTY	SPRINGFIELD	TH-5	BROOK RD	2.200	11,616.00
WINDSOR COUNTY	SPRINGFIELD	TH-6	MILL RD	0.120	633.60
WINDSOR COUNTY	SPRINGFIELD	TH-6	MAIN ST, NS	1.480	7,814.40
WINDSOR COUNTY	SPRINGFIELD	TH-7	AIRPORT RD	0.120	633.60
WINDSOR COUNTY	SPRINGFIELD	TH-8	BALTIMORE RD	0.810	4,276.80
WINDSOR COUNTY	SPRINGFIELD	TH-9	RESERVOIR RD	1.680	8,870.40
WINDSOR COUNTY	SPRINGFIELD	TH-9	RESERVOIR RD FRK	0.030	158.40
WINDSOR COUNTY	SPRINGFIELD	TH-10	ELM ST	0.330	1,742.40
WINDSOR COUNTY	SPRINGFIELD	TH-10	SPOONERVILLE RD	0.400	2,112.00
WINDSOR COUNTY	STOCKBRIDGE	TH-1	BLACKMER BLVD	2.620	13,833.60
WINDSOR COUNTY	STOCKBRIDGE	TH-2	BRIDGE ST	0.130	686.40
WINDSOR COUNTY	STOCKBRIDGE	TH-2	RIVER RD	0.390	2,059.20
WINDSOR COUNTY	WEATHERSFIELD	TH-1	WEATHERSFIELD CENTER RD	5.250	27,720.00
<b>WINDSOR COUNTY SHEET 2 TOTAL</b>				<b>85.090</b>	<b>449,275.20</b>

PROJECT NAME:	STATEWIDE SOUTHEAST REGION
PROJECT NUMBER:	STPG MARK(308)
FILE NAME: z16+087.dgn	PLOT DATE: 2/9/2017
PROJECT LEADER: C. LATHROP	DRAWN BY: P. DAY
DESIGNED BY: P. DAY	CHECKED BY: C. LATHROP
CLASS 2 TOWN HIGHWAY QUANTITY SHEET 7 SHEET 15 OF 16	

## SUMMARY BY COUNTY OF CLASS 2 TOWN HIGHWAYS

COUNTY	TOWN	TH NUMBER	TH NAME	MILEAGE	LINEAR FT
WINDSOR COUNTY	WEATHERSFIELD	TH-3	AIRPORT RD	0.480	2,534.40
WINDSOR COUNTY	WEATHERSFIELD	TH-4	RESERVOIR RD	2.583	13,638.24
WINDSOR COUNTY	WEATHERSFIELD	TH-4	STOUGHTON POND RD	0.037	195.36
WINDSOR COUNTY	WEATHERSFIELD	TH-6	STOUGHTON POND RD	1.280	6,758.40
WINDSOR COUNTY	WEST WINDSOR	TH-1	BROWNSVILLE HARTLAND RD	4.700	24,816.00
WINDSOR COUNTY	WEST WINDSOR	TH-2	SKI TOW RD	0.821	4,334.88
WINDSOR COUNTY	WESTON	TH-1	CHESTER MOUNTAIN RD	1.370	7,233.60
WINDSOR COUNTY	WESTON	TH-2	LANDGROVE RD	0.352	1,858.56
WINDSOR COUNTY	WESTON	TH-2	LAWRENCE HILL RD	0.260	1,372.80
WINDSOR COUNTY	WINDSOR	TH-3	STATE ST	0.720	3,801.60
WINDSOR COUNTY	WINDSOR	TH-3	COUNTY RD	3.650	19,272.00
WINDSOR COUNTY	WINDSOR	TH-4	BRIDGE ST	0.220	1,161.60
WINDSOR COUNTY	WINDSOR	TH-5	ASCUTNEY ST	0.260	1,372.80
WINDSOR COUNTY	WINDSOR	TH-6	COLE HILL RD	0.450	2,376.00
WINDSOR COUNTY	WOODSTOCK	TH-1	POMFRET RD	0.880	4,646.40
WINDSOR COUNTY	WOODSTOCK	TH-2	COVERED BRIDGE RD	0.110	580.80
WINDSOR COUNTY	WOODSTOCK	TH-3	PROSPER RD	0.127	670.56
WINDSOR COUNTY	WOODSTOCK	TH-4	CHURCH HILL RD	1.740	9,187.20
WINDSOR COUNTY	WOODSTOCK	TH-5	HARTLAND HILL RD	1.390	7,339.20
WINDSOR COUNTY	WOODSTOCK	TH-5	PLEASANT ST	0.320	1,689.60
WINDSOR COUNTY	WOODSTOCK	TH-6	THE GREEN	0.030	158.40
WINDSOR COUNTY	WOODSTOCK	TH-6	SAINT JAMES PL	0.010	52.80
WINDSOR COUNTY	WOODSTOCK	TH-6	CHURCH HILL RD	0.080	422.40
WINDSOR COUNTY	WOODSTOCK	TH-6	PROSPECT ST	0.410	2,164.80
<b>WINDSOR COUNTY SHEET 3 TOTAL</b>				<b>22.280</b>	<b>117,638.40</b>
<b>WINDSOR COUNTY SHEET 1 TOTAL</b>				<b>79.623</b>	<b>1,161.60</b>
<b>WINDSOR COUNTY SHEET 2 TOTAL</b>				<b>85.090</b>	<b>3,801.60</b>
<b>WINDSOR COUNTY SHEET 3 TOTAL</b>				<b>22.280</b>	<b>117,638.40</b>
<b>WINDSOR COUNTY TOTAL</b>				<b>186.993</b>	<b>122,601.60</b>

PROJECT NAME:	STATEWIDE SOUTHEAST REGION
PROJECT NUMBER:	STPG MARK(308)
FILE NAME: z16+087.dgn	PLOT DATE: 2/9/2017
PROJECT LEADER: C. LATHROP	DRAWN BY: P. DAY
DESIGNED BY: P. DAY	CHECKED BY: C. LATHROP
CLASS 2 TOWN HIGHWAY QUANTITY SHEET 8 SHEET 16 OF 16	