

INDEX OF SHEETS

- 1 TITLE SHEET
- 2 QUANTITY SHEET
- 3 TRAFFIC CONTROL PLAN
- 4 MISCELLANEOUS DETAILS SHEET
- 5-7 ROAD QUANTITY SHEETS 1-3
- 8 ROAD SUMMARY SHEET
- 9-17 CLASS 2 TOWN HIGHWAY QUANTITIES SHEET 1-9

VAOT STANDARDS

- E-192 10/12/2000
- E-193 08/18/1995
- T-1 04/25/2016
- T-11 08/06/2012
- T-12 08/06/2012
- T-22 08/06/2012
- T-23 08/06/2012
- T-24 08/06/2012
- T-28 08/06/2012
- T-29 08/06/2012
- T-31 08/06/2012


STATE OF VERMONT AGENCY OF TRANSPORTATION




PROPOSED IMPROVEMENT STATEWIDE - SOUTHWEST REGION NATIONAL HIGHWAY SYSTEM, STATE ROAD, CLASS 1 & CLASS 2 TOWN HIGHWAYS

APPLICATION OF CENTER LINE, EDGE LINE AND LANE LINE MARKINGS ON NATIONAL HIGHWAY AND STATE SYSTEM ROADS. APPLICATION OF CENTER LINE MARKINGS ONLY ON CLASS 1 AND CLASS 2 TOWN HIGHWAYS WITHIN ADDISON, BENNINGTON, RUTLAND, WINDHAM, AND WINDSOR COUNTIES.

LENGTH OF PROJECT 969.504 MI = 5,118,981.12 LF

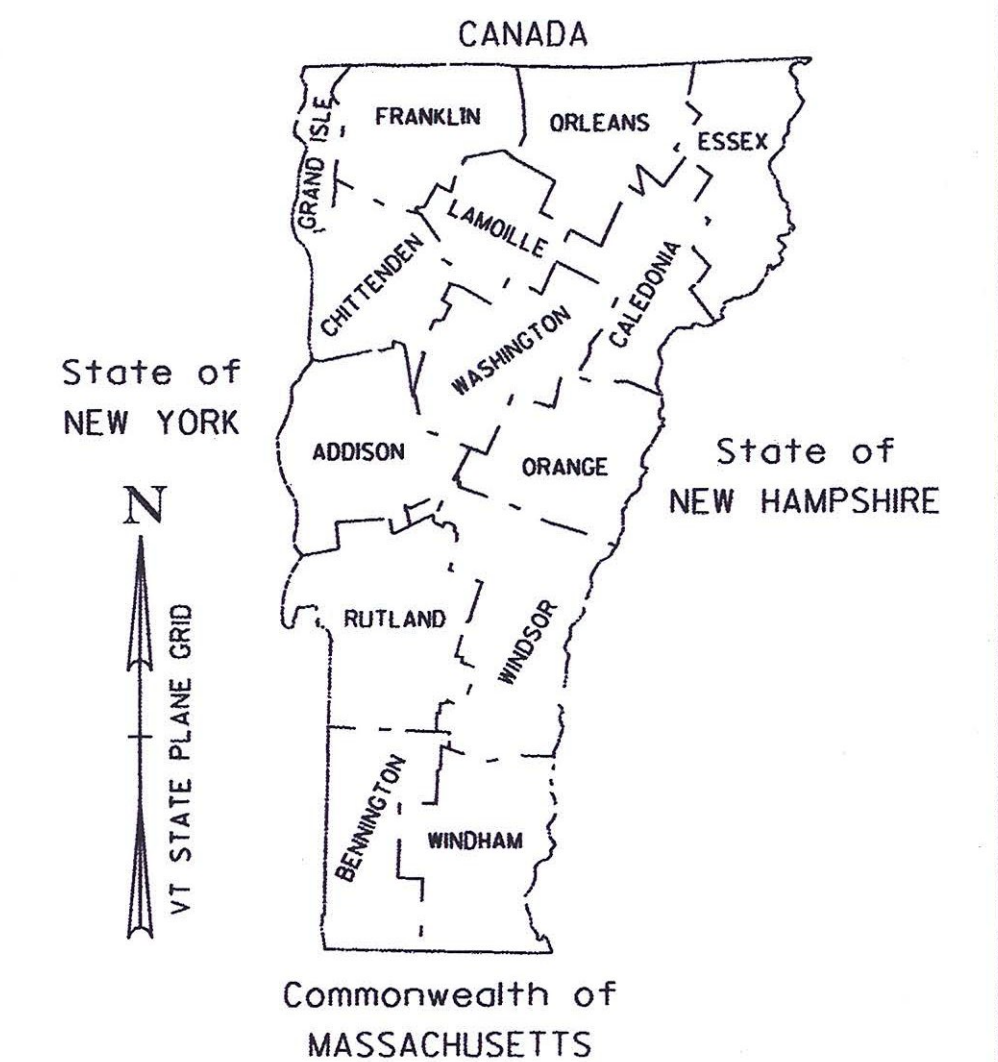

RECORD PLANS	
CONTRACTOR:	HI-WAY SAFETY SYSTEMS, INC. - ROCKLAND, MA
RESIDENT ENGINEER:	TOM CHASE
CONSTRUCTION BEGAN:	MAY 23, 2017
CONSTRUCTION COMPLETE:	NOVEMBER 13, 2017
RECORD PLANS BY:	TOM CHASE & JESSE IVES
I HEREBY CERTIFY THAT ALL THE CONSTRUCTION REQUIRED BY THIS SET OF DRAWINGS HAS BEEN ACCOMPLISHED AS INDICATED HEREIN.	
BY	<i>Thomas A. Chase</i> RESIDENT ENGINEER
DATE	<u>01/30/18</u>
NOTE: Any further information concerning final quantities, amounts or other details relative to this project may be found at Central Files in the electronic archives.	

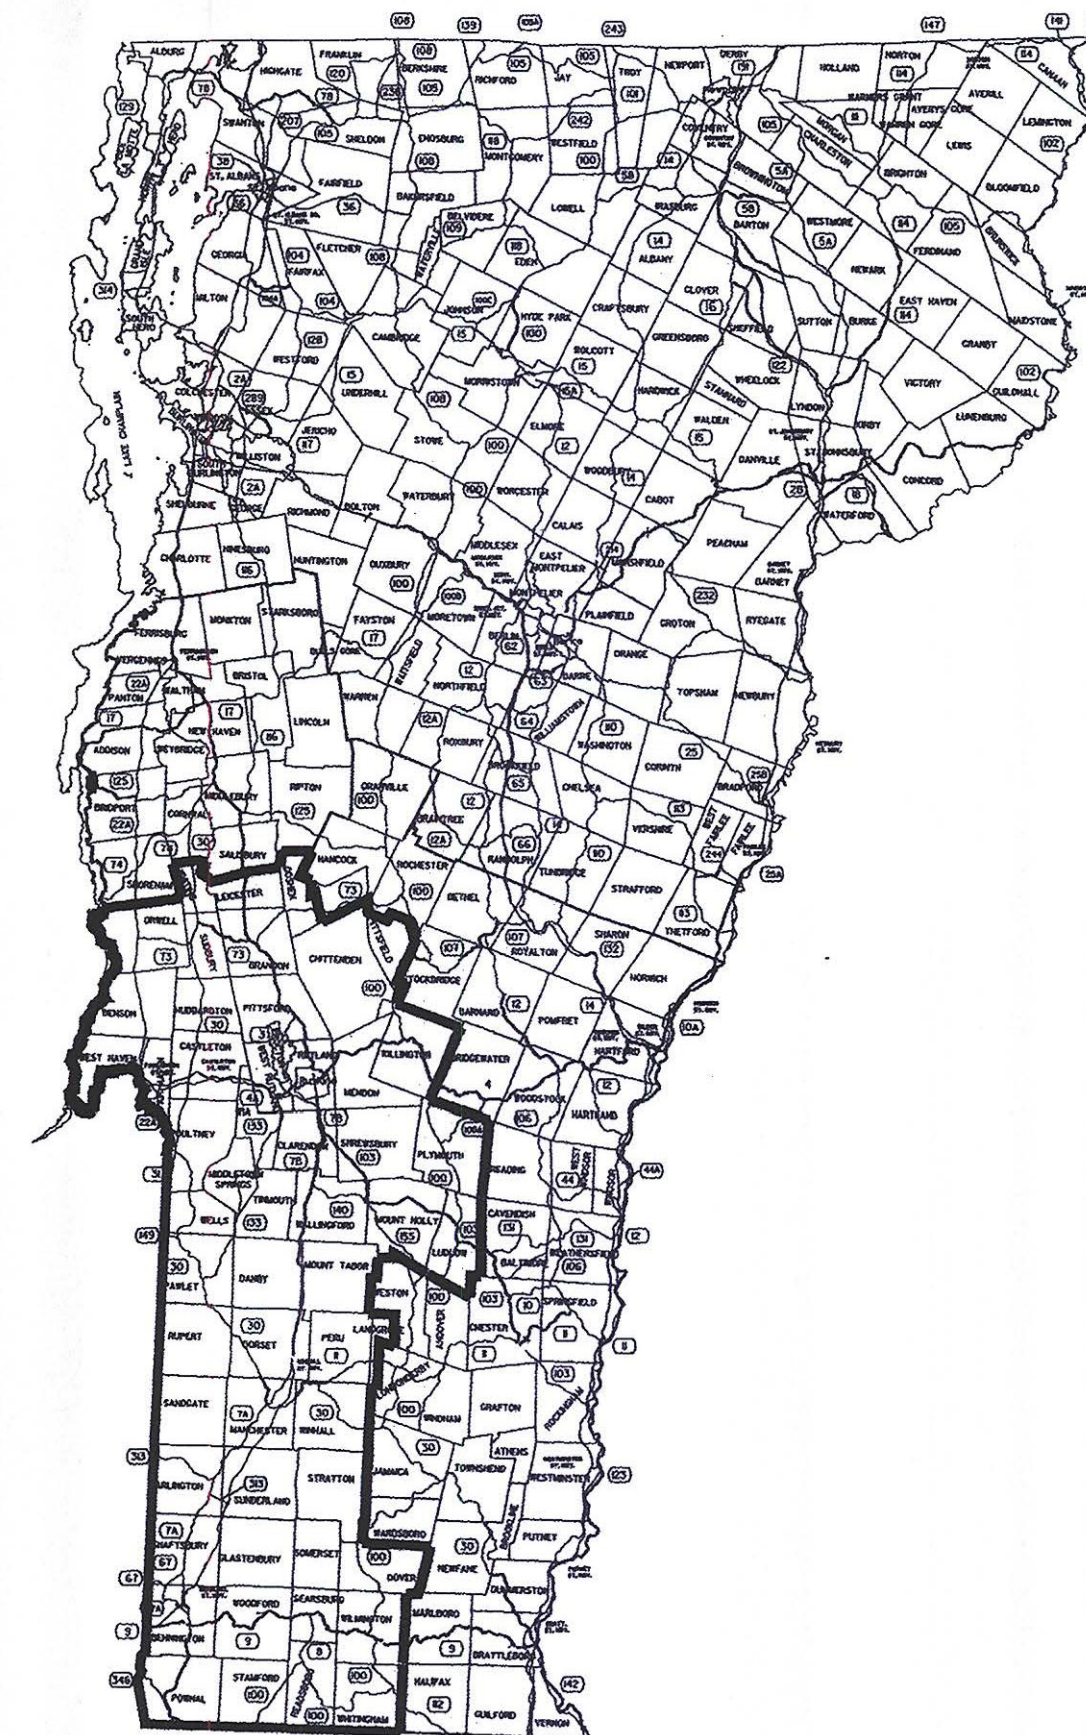

CONSTRUCTION IS TO BE CARRIED ON IN ACCORDANCE WITH THESE PLANS AND THE STANDARD SPECIFICATIONS FOR CONSTRUCTION DATED 201 1, AS APPROVED BY THE FEDERAL HIGHWAY ADMINISTRATION ON JULY 20, 201 1 FOR USE ON THIS PROJECT, INCLUDING ALL SUBSEQUENT REVISIONS AND SUCH REVISED SPECIFICATIONS AND SPECIAL PROVISIONS AS ARE INCORPORATED IN THESE PLANS.



QUALITY ASSURANCE PROGRAM : LEVEL 1	
SURVEYED BY :	N/A
SURVEYED DATE :	N/A
DATUM	
VERTICAL	N/A
HORIZONTAL	N/A

BUILT AS DESIGNED

		DIRECTOR OF PROJECT DELIVERY APPROVED <i>[Signature]</i> DATE <u>2/6/2017</u>
	PROJECT MANAGER : PATRICIA COBURN P.E.	
	PROJECT NAME : STATEWIDE-SOUTHWEST REGION PROJECT NUMBER : STPG MARK(309)	
	SHEET 1 OF 17 SHEETS	