


STATE OF VERMONT AGENCY OF TRANSPORTATION





PROPOSED IMPROVEMENT TOWN OF ST. ALBANS COUNTY OF FRANKLIN VT ROUTE 36 - MAJOR COLLECTOR AND VT ROUTE 38 - MAJOR COLLECTOR

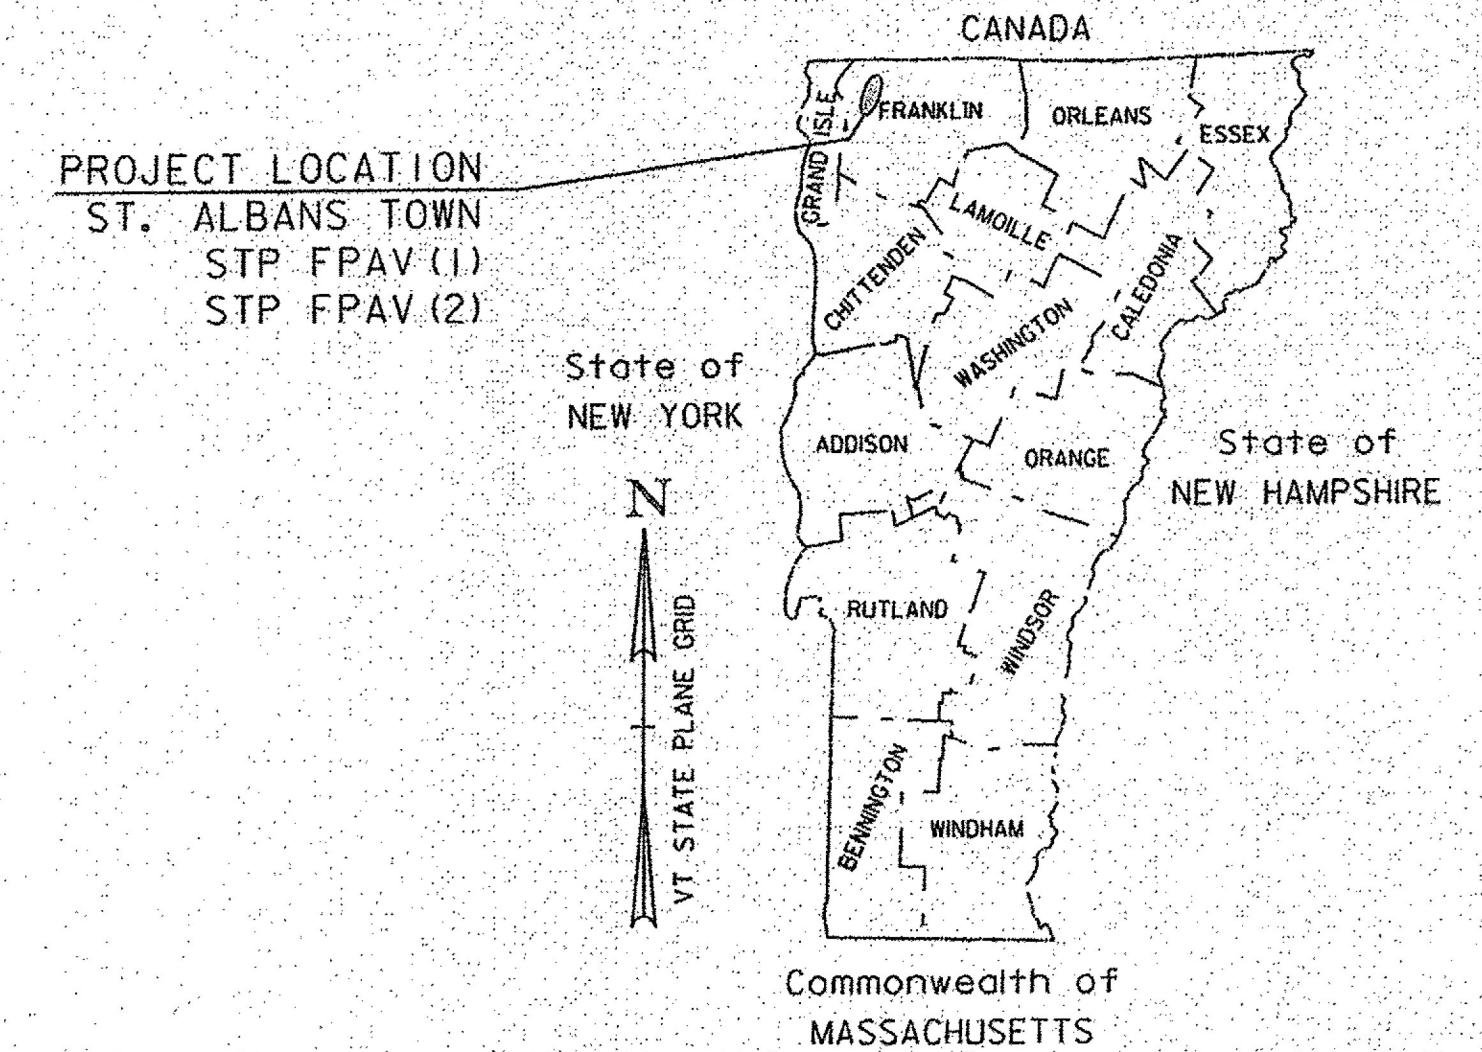

RECORD PLANS	
CONTRACTOR:	F.W. WHITCOMB CONSTRUCTION CORP. - WALPOLE, NH
RESIDENT ENGINEER:	SCOTT WHEATLEY
CONSTRUCTION BEGAN:	APRIL 24, 2017
CONSTRUCTION COMPLETE:	JUNE 02, 2017
RECORD PLANS BY:	SCOTT WHEATLEY & JESSE IVES
I HEREBY CERTIFY THAT ALL THE CONSTRUCTION REQUIRED BY THIS SET OF DRAWINGS HAS BEEN ACCOMPLISHED AS INDICATED HEREIN.	
BY	RESIDENT ENGINEER
DATE	July 24, 2018
NOTE: Any further information concerning final quantities, amounts or other details relative to this project may be found at Central Files in the electronic archives.	


**ST. ALBANS STP FPAV(1)
VT 36
(SEE SHEET 9 OF 32)**

**ST. ALBANS STP FPAV(2)
VT 38
(SEE SHEET 22 OF 32)**

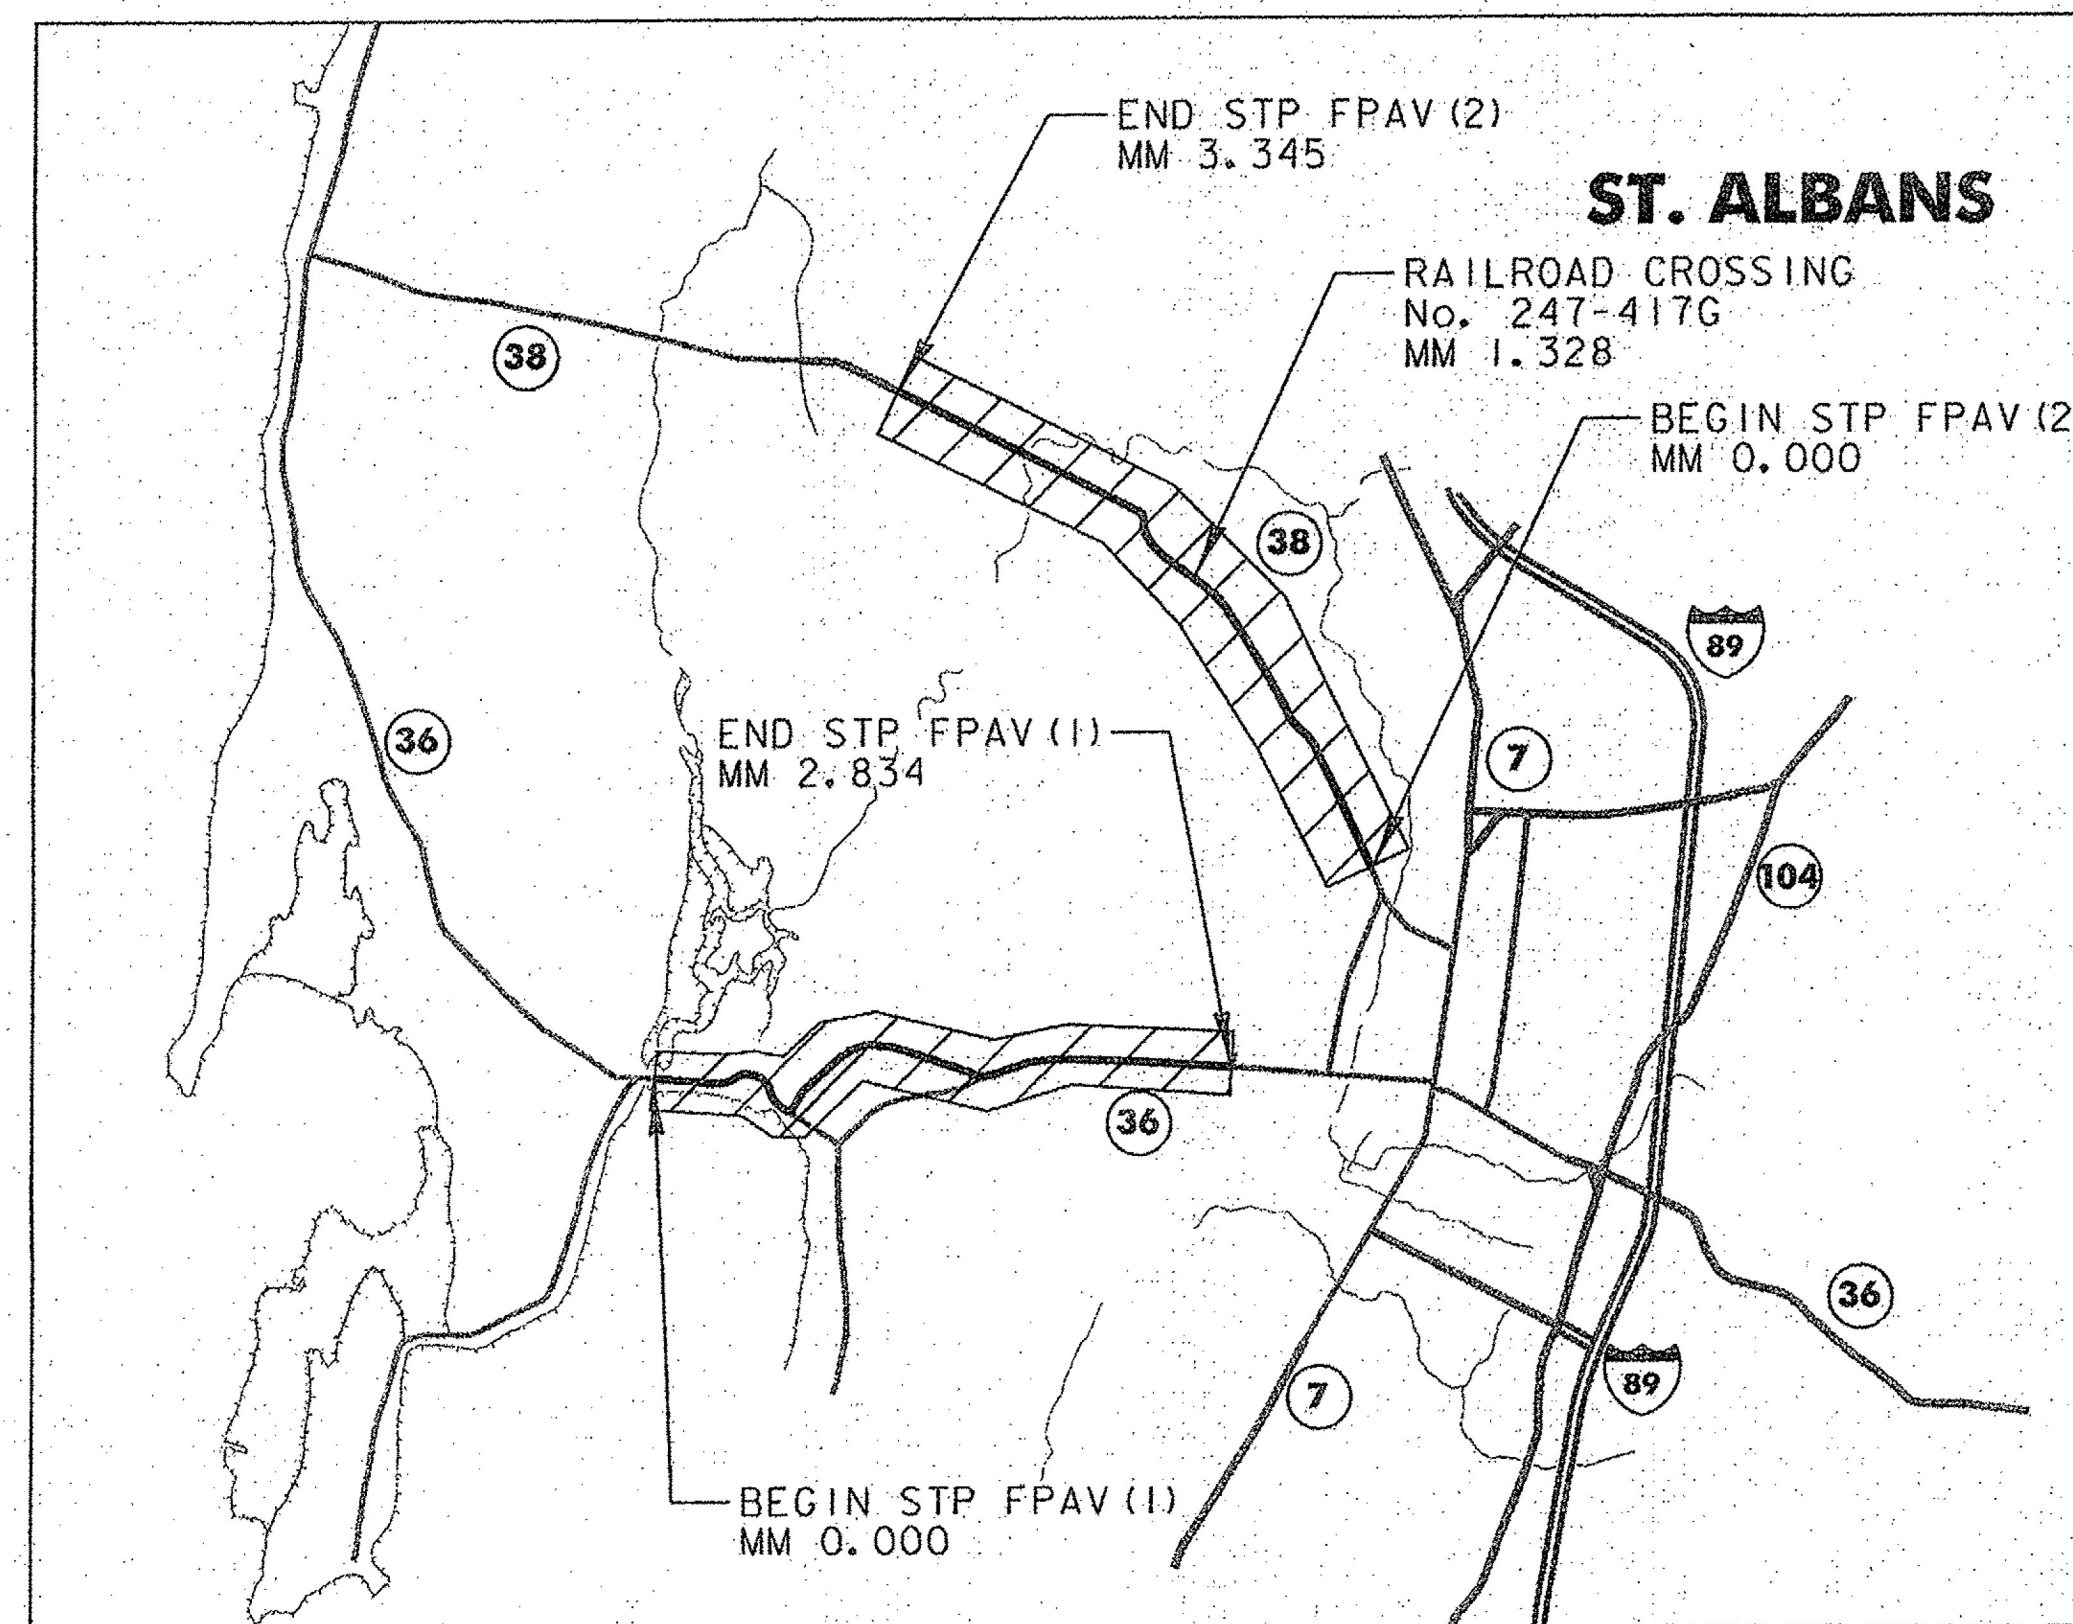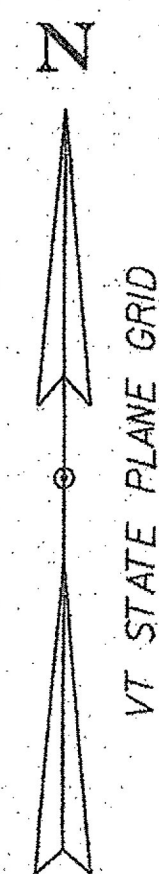

CONSTRUCTION IS TO BE CARRIED ON IN ACCORDANCE WITH THESE PLANS AND THE STANDARD SPECIFICATIONS FOR CONSTRUCTION DATED 2011, AS APPROVED BY THE FEDERAL HIGHWAY ADMINISTRATION ON JULY 20, 2011 FOR USE ON THIS PROJECT, INCLUDING ALL SUBSEQUENT REVISIONS AND SUCH REVISED SPECIFICATIONS AND SPECIAL PROVISIONS AS ARE INCORPORATED IN THESE PLANS.

QUALITY ASSURANCE PROGRAM : LEVEL 3	
SURVEYED BY :	N/A
SURVEYED DATE :	N/A
DATUM	
VERTICAL	N/A
HORIZONTAL	N/A

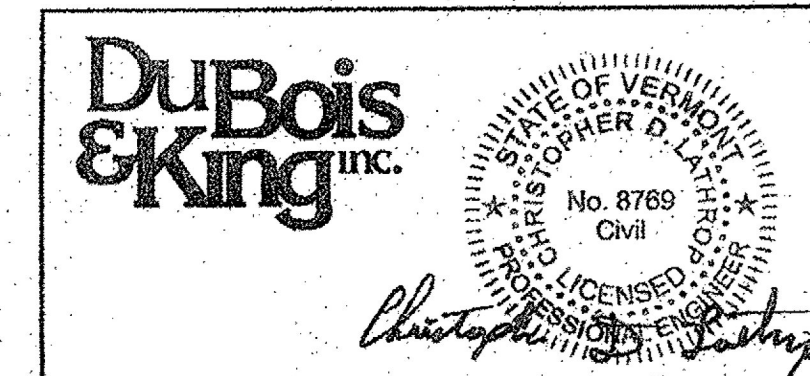

DIRECTOR OF PROJECT DELIVERY	
APPROVED	DATE 5/23/2018
PROJECT MANAGER : MICHAEL J. FOWLER, P.E.	
PROJECT NAME :	ST ALBANS TOWN
PROJECT NUMBER :	STP FPAV(1)/STP FPAV(2)
SHEET 1 OF 32 SHEETS	