

REHAB DROP INLETS, CATCH BASINS OR  
 MANHOLES, CLASS I, CLASS II, CLASS III  
~~MM 0.717 LT~~  
 MM 0.775 LT  
 MM 0.817 LT  
 MM 0.867 LT

4 INCH WHITE LINE, WATERBORNE PAINT &  
 TEMPORARY 4 INCH WHITE LINE, PAINT  
 (ALL LINES WILL INCLUDE EDGE LINE BREAKS  
 AND RADII AT TOWN HIGHWAYS)  
 MM 0.412 - MM 1.600 (SOLID LT & RT)  
 4 INCH YELLOW LINE, WATERBORNE PAINT &  
 TEMPORARY 4 INCH YELLOW LINE, PAINT  
 (ALL LINES WILL INCLUDE CENTERLINE BREAKS  
 AT TOWN HIGHWAYS)  
 MM 0.412 - MM 1.600 (SOLID LT & RT)


24 INCH STOP BAR, WATERBORNE PAINT &  
 TEMPORARY 24 INCH STOP BAR, PAINT  
 MM 1.544 - MM 1.550 LT (TH#14)  
 LETTER OR SYMBOL, WATERBORNE PAINT &  
 TEMPORARY LETTER OR SYMBOL, PAINT  
 MM 1.547 LT (STOP) (TH#14)

END TRANSITION  
 BEGIN LEVEL/OVERLAY  
 MM 0.800

BEGIN TRANSITION  
 END OVERLAY  
 MM 0.795


MATCH LINE MM 0.412 SEE PREVIOUS SHEET

MATCH LINE MM 1.000 SEE BELOW LEFT

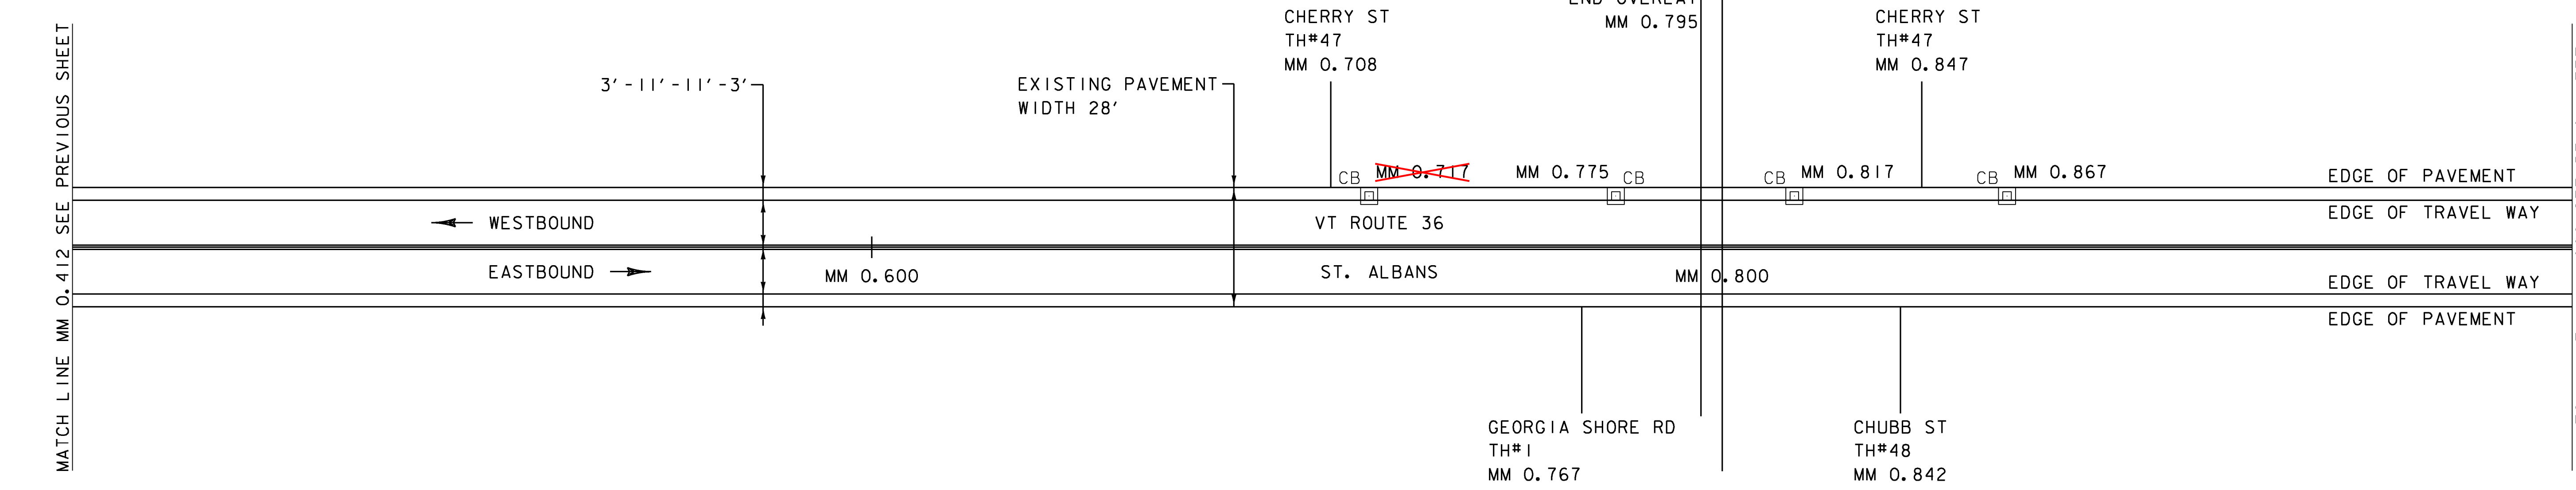

MATCH LINE MM 1.000 SEE ABOVE RIGHT

MATCH LINE MM 1.600 SEE NEXT SHEET

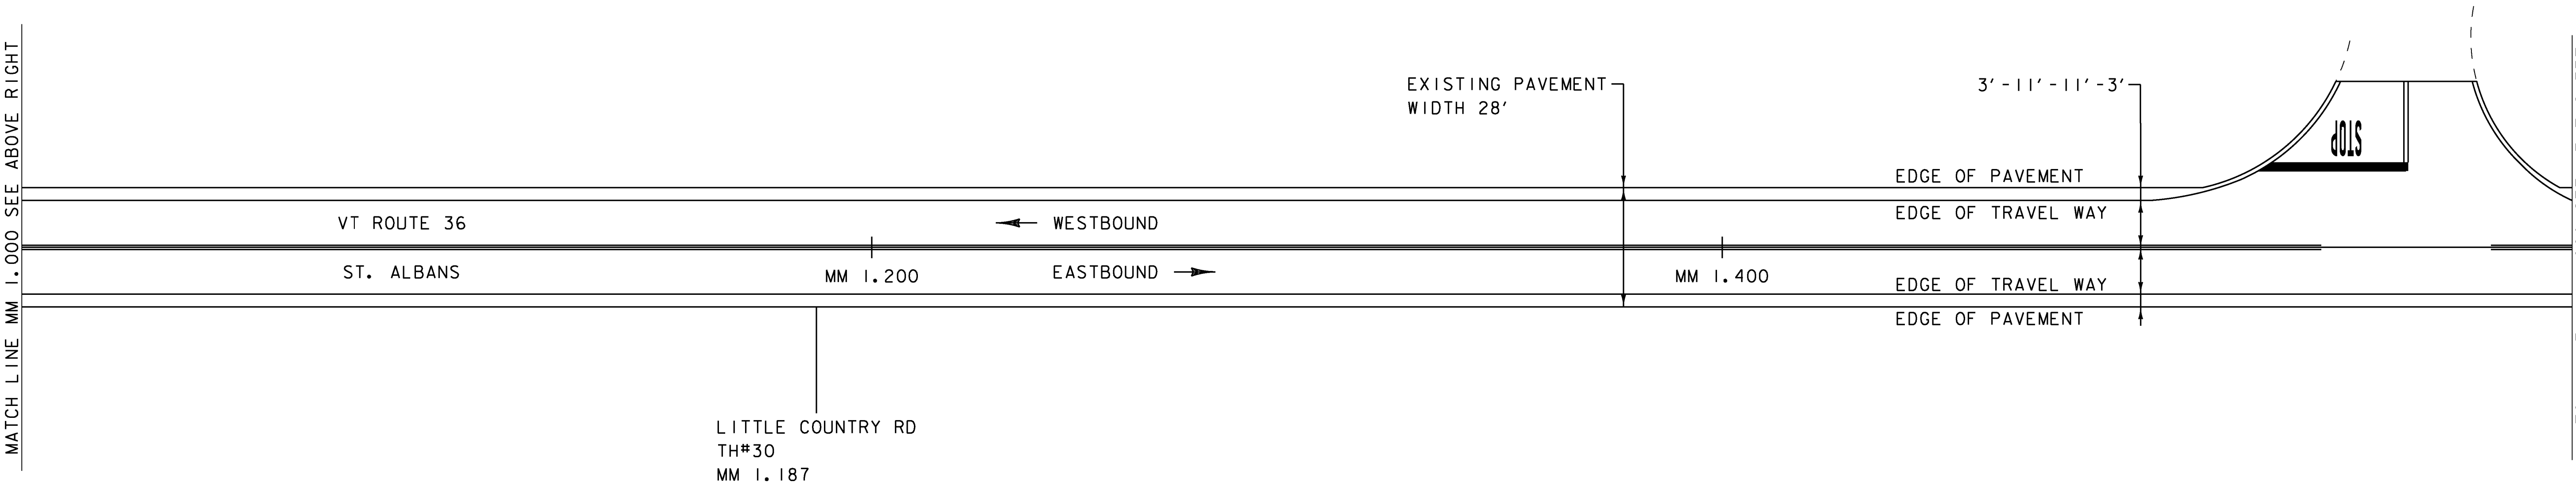

NOT TO SCALE

PROJECT NAME: ST ALBANS TOWN	
PROJECT NUMBER: STP FPAV(I)	
FILE NAME: z16v020bdr.dgn	PLOT DATE: 05/10/2016
PROJECT LEADER: C. LATHROP	DRAWN BY: J. GOODALL
DESIGNED BY: J. GOODALL	CHECKED BY: C. LATHROP
PLAN SHEET 3	SHEET 18 OF 32