

REHAB DROP INLETS CATCH BASINS OR
 MANHOLES, CLASS I, CLASS II, CLASS III
~~MM 2.726 LT~~
~~MM 2.753 LT~~



STEEL BEAM GUARDRAIL, GALVANIZED
 MM 2.075 - MM 2.082 RT
 MM 2.163 - MM 2.170 RT
 MM 2.320 - MM 2.327 RT
 MM 2.389 - MM 2.397 RT

ANCHOR FOR STEEL BEAM RAIL
 MM 2.075 RT
 MM 2.170 RT
 MM 2.320 RT
 MM 2.397 RT

REMOVAL AND DISPOSAL OF GUARDRAIL
 MM 2.075 - MM 2.082 RT
 MM 2.163 - MM 2.170 RT
 MM 2.320 - MM 2.327 RT
 MM 2.389 - MM 2.397 RT

4 INCH WHITE LINE, WATERBORNE PAINT &
 TEMPORARY 4 INCH WHITE LINE, PAINT
 (ALL LINES WILL INCLUDE EDGE LINE BREAKS
 AND RADII AT TOWN HIGHWAYS)
 MM 1.600 - MM 2.800 (SOLID LT & RT)

4 INCH YELLOW LINE, WATERBORNE PAINT &
 TEMPORARY 4 INCH YELLOW LINE, PAINT
 (ALL LINES WILL INCLUDE CENTERLINE BREAKS
 AT TOWN HIGHWAYS)
 MM 1.600 - MM 2.800 (SOLID LT & RT)

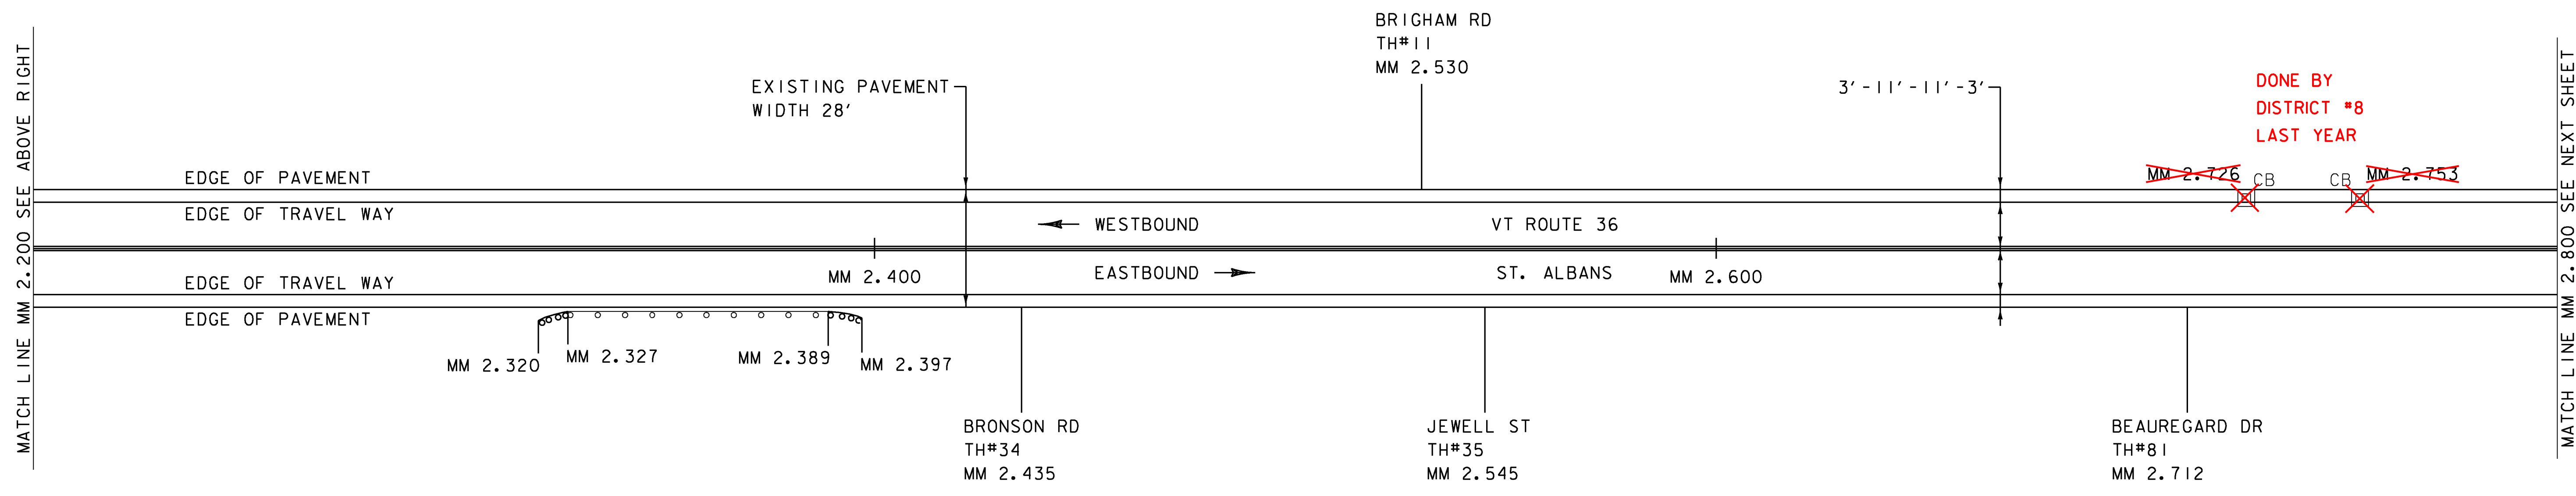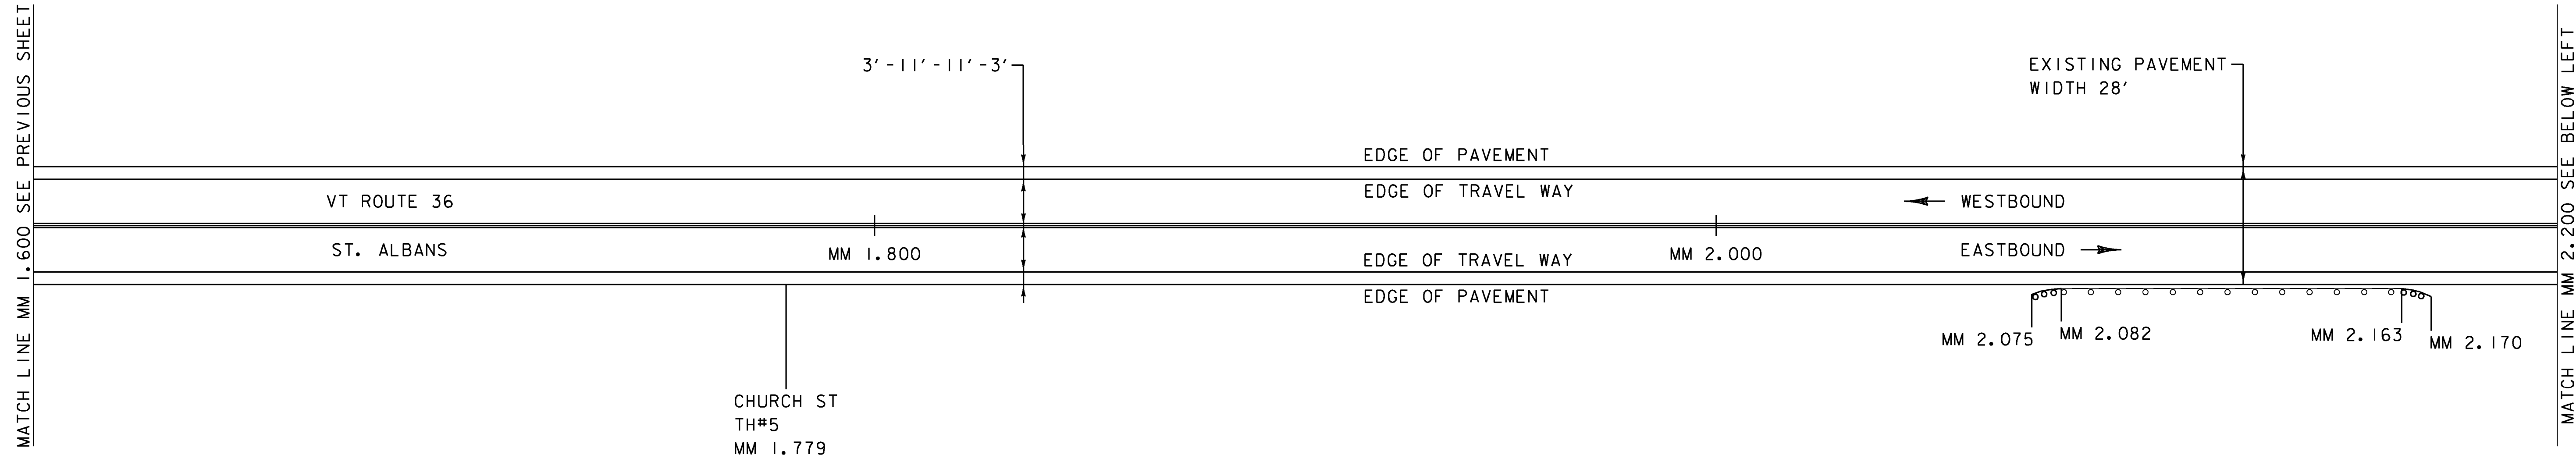

PROJECT NAME:	ST ALBANS TOWN	PLOT DATE:	05/10/2016
PROJECT NUMBER:	STP FPAV(I)	DRAWN BY:	J. GOODALL
FILE NAME:	z16v020bdr.dgn	DESIGNED BY:	J. GOODALL
PROJECT LEADER:	C. LATHROP	CHECKED BY:	C. LATHROP
PLAN SHEET 4		SHEET	19 OF 32

NOT TO SCALE